


Area Map



Aerial Photograph

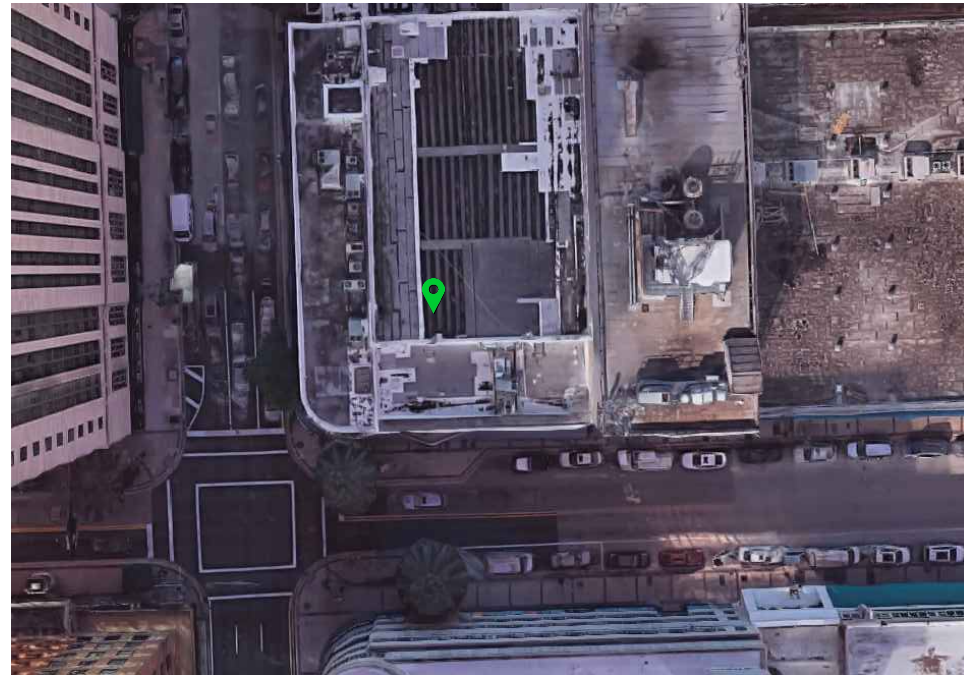

Existing Site Photograph



360 Photo / As-Built Survey

Project Name

Address

Project Total S.F.

38470

Arktech Solutions LLC

10804 Inside Loop

Orlando, FL 32825

O. 407.205.7787

P 214 606 5281

www.arktechsolution.com



SCALE: NTS

OWNER: CLIENT:

- 01 360 Vantage Point (Web Link)
- 01 Still Photo
- 01 Red Flag Notification



ACCESSIBLE PARKING STALL



ACCESSIBLE PATH OF TRAVEL




Arktech Solutions LLC.
10804 Inside Loop
Orlando, FL 32825
tel: (407) 205-7787
www.ArktechSolution.com


FC NAME: ----
FCID: N/A
FC ADDRESS: ---- ---- ----

FIELD SURVEYOR: ----
PROJECT DIRECTOR: ----
CHECKED BY: ----
DATE COMPLETED: 05/03/2022

PROJECT NUMBER: #####	
SHEET: SP01	
DRAWING NUMBER: 2	OF: 24
DRAWING NAME: SITE PLAN	

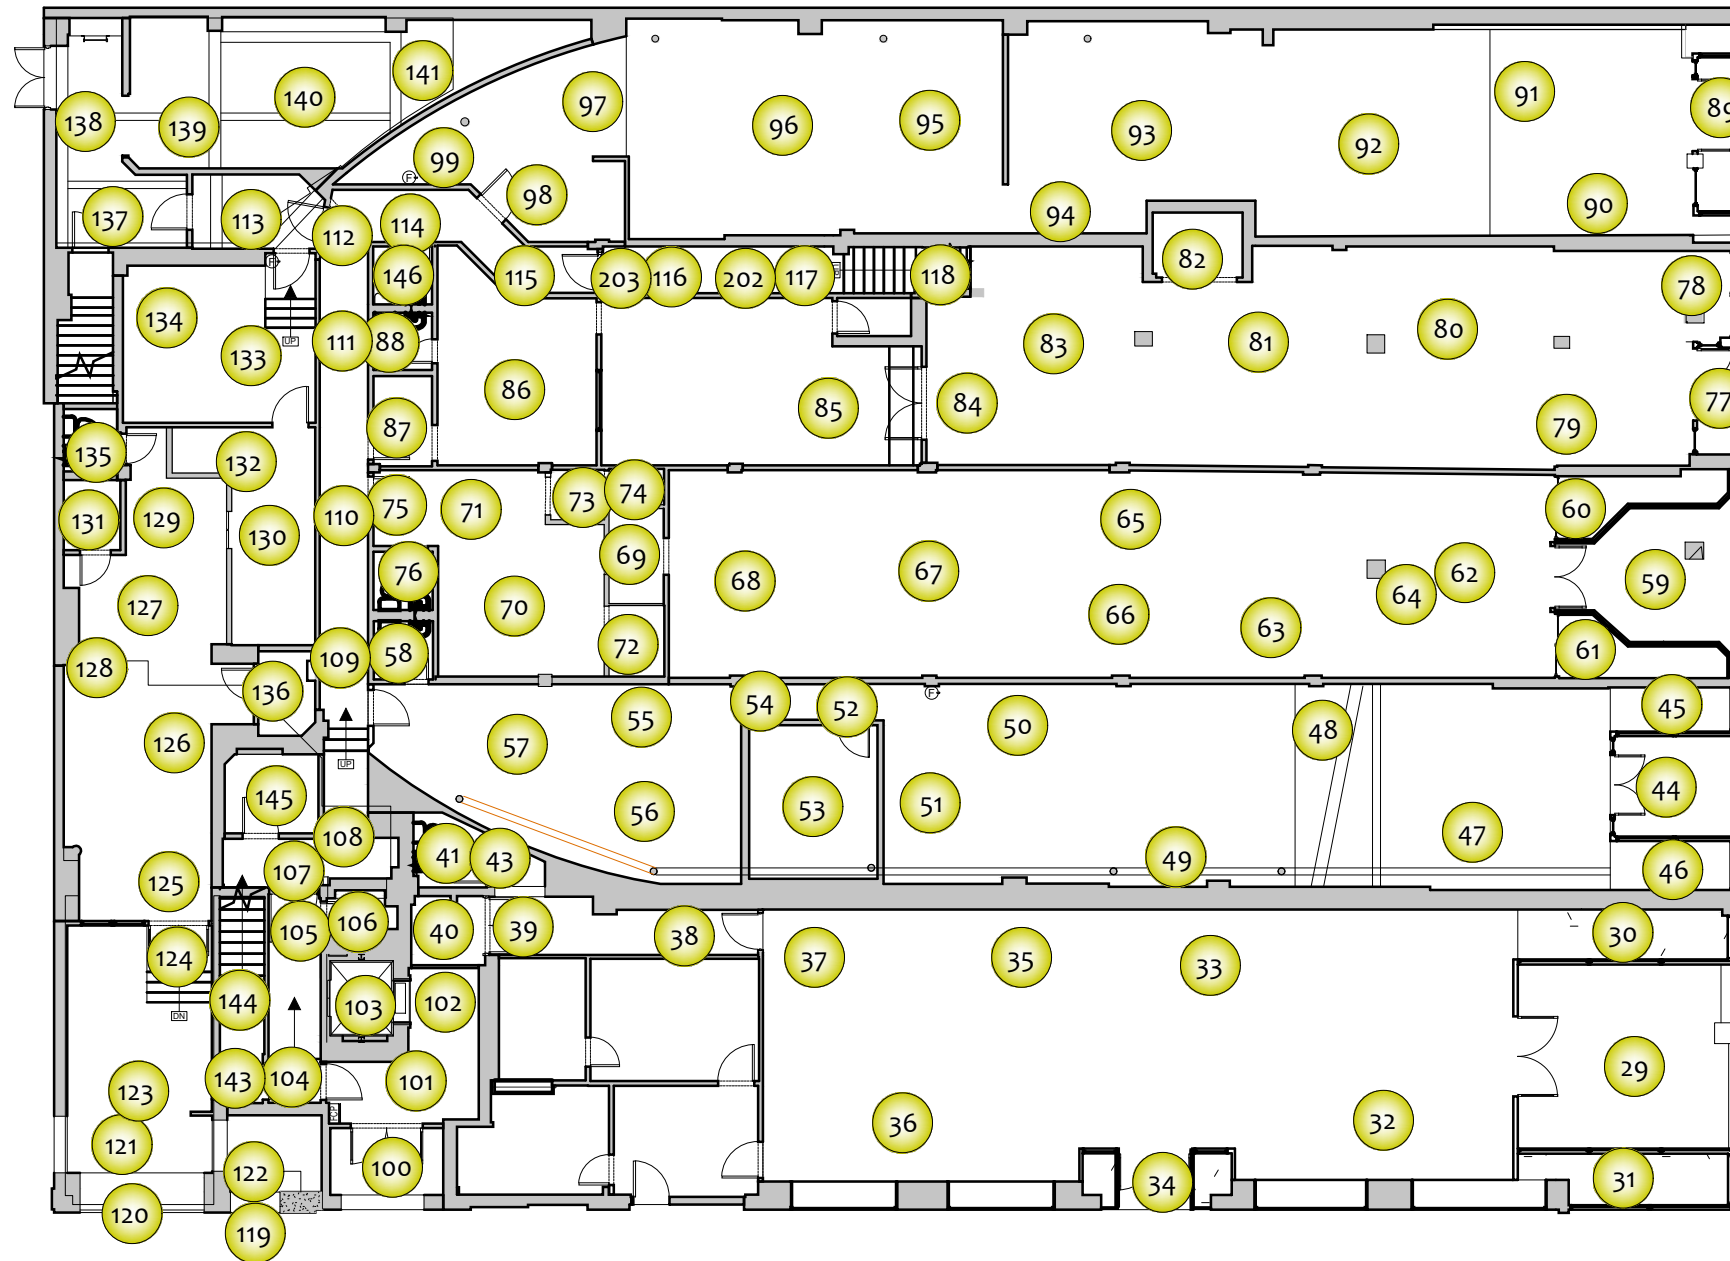

FLOOR GROSS SF: 14,148

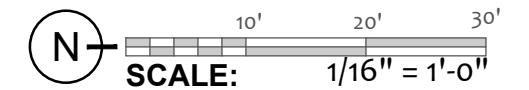

OWNER:

CLIENT:

- 01 360 Vantage Point (Web Link)
- 01 Still Photo
- 01 Red Flag Notification




Arktech Solutions LLC.
10804 Inside Loop
Orlando, FL 32825
tel: (407) 205-7787
www.ArktechSolution.com


FC NAME:	---
FCID:	N/A
FC ADDRESS:	---

FIELD SURVEYOR:	---
PROJECT DIRECTOR:	---
CHECKED BY:	---
DATE COMPLETED:	05/03/2022

PROJECT NUMBER: #####	
SHEET: A001.1	
DRAWING NUMBER: 3	OF: 24
DRAWING NAME: 360 1st Floor Plan	

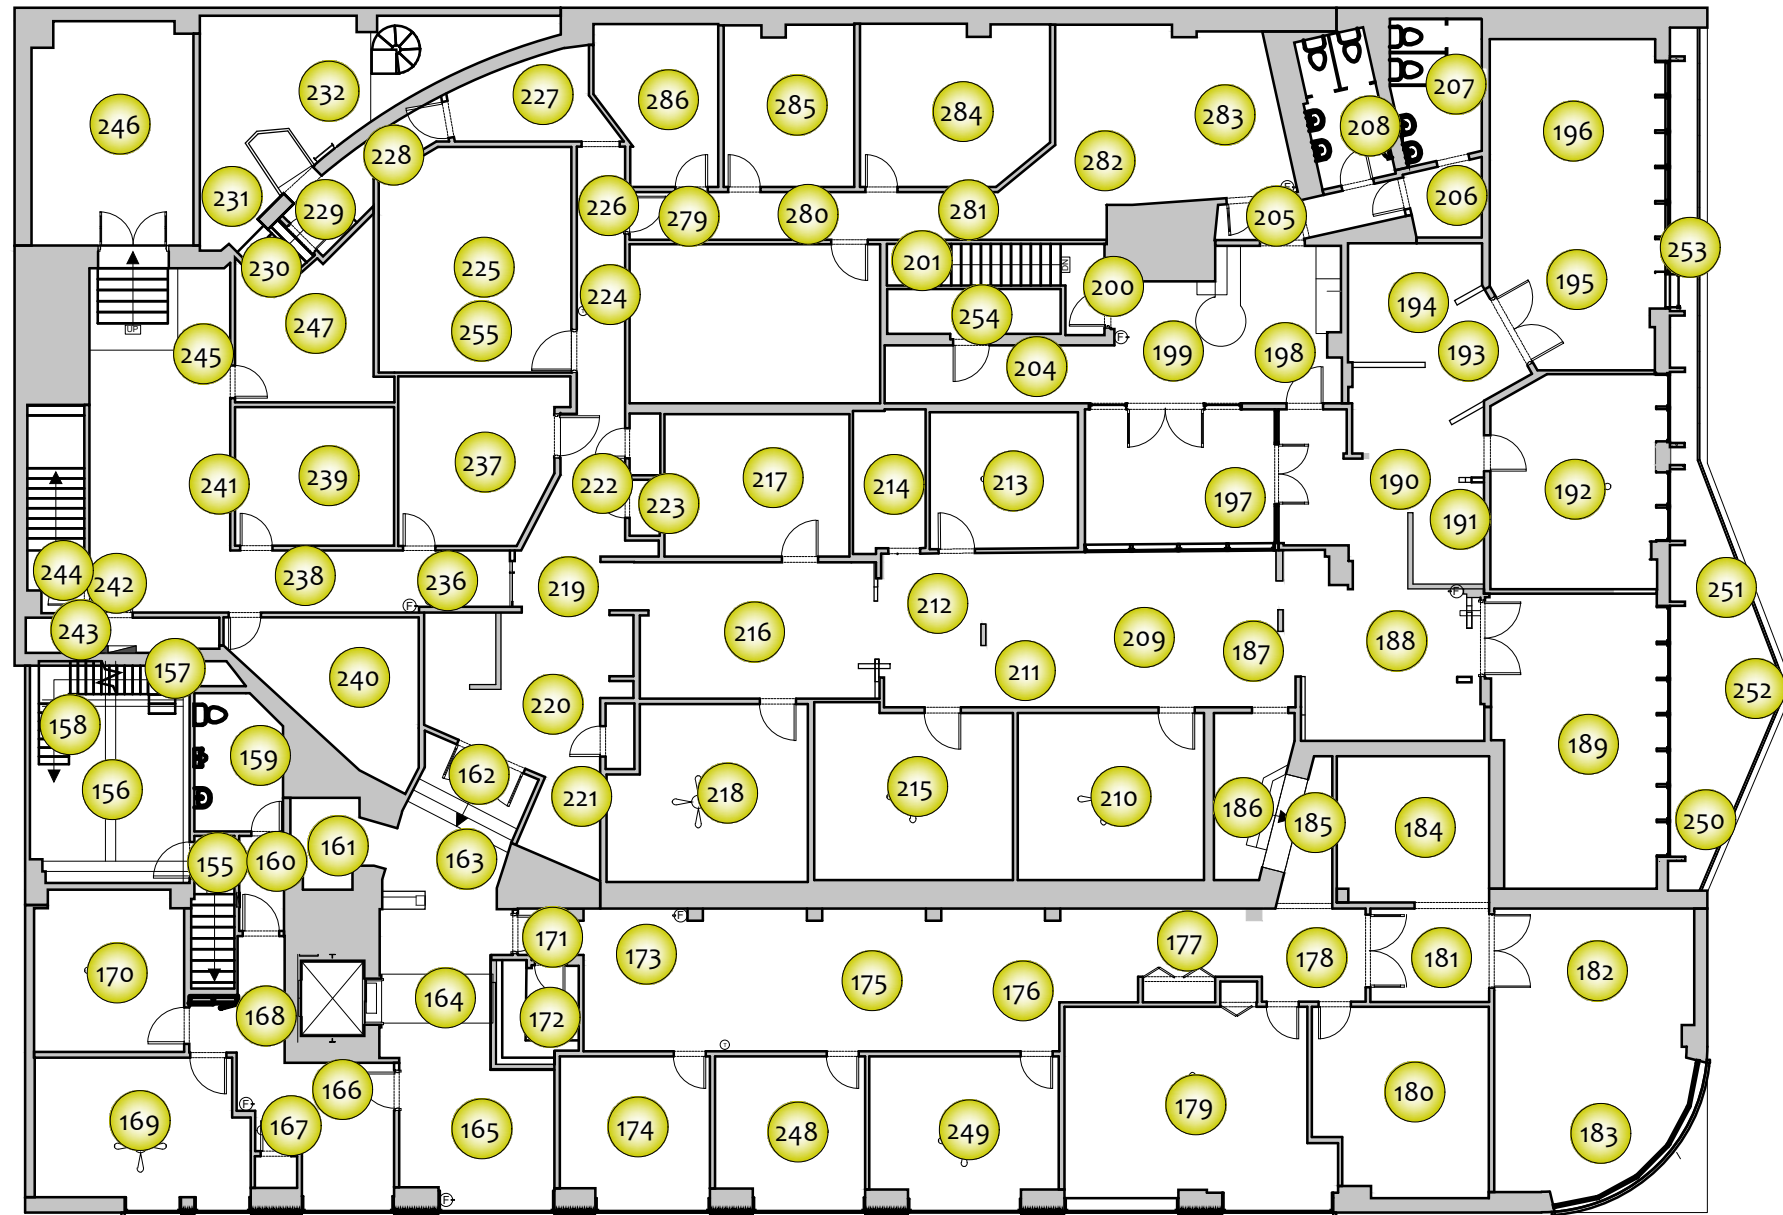

FLOOR GROSS SF: 14,157

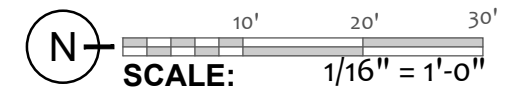

OWNER:

CLIENT:

- 01 360 Vantage Point (Web Link)
- 01 Still Photo
- 01 Red Flag Notification




Arktech Solutions LLC.
10804 Inside Loop
Orlando, FL 32825
tel: (407) 205-7787
www.ArktechSolution.com


FC NAME:	---
FCID:	N/A
FC ADDRESS:	---

FIELD SURVEYOR:	---
PROJECT DIRECTOR:	---
CHECKED BY:	---
DATE COMPLETED:	05/03/2022


PROJECT NUMBER:	####		
SHEET:	A001.2		
DRAWING NUMBER:	4	OF:	24
DRAWING NAME:			
360 2nd Floor Plan			

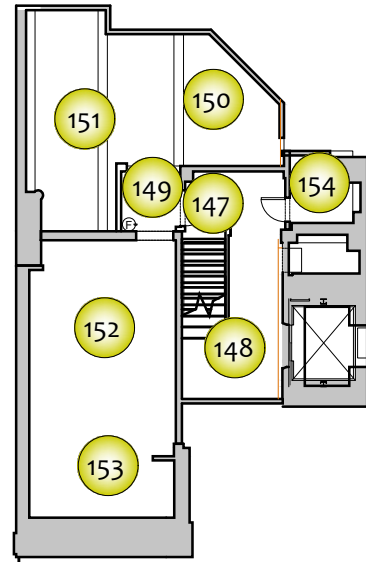

① MEZZANINE 1 FLOOR PLAN

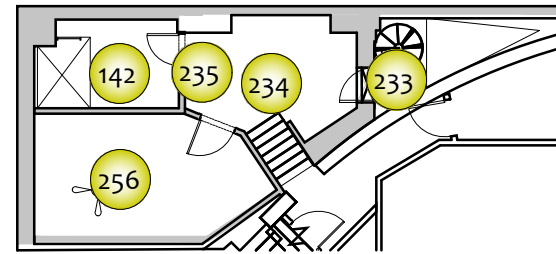


② MEZZANINE 2 FLOOR PLAN

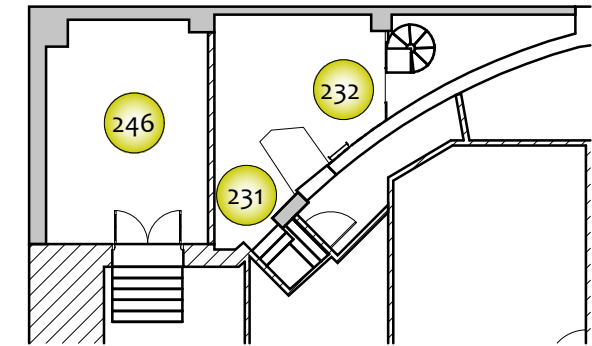


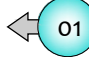

③ MEZZANINE 3 FLOOR PLAN

FLOOR GROSS SF:

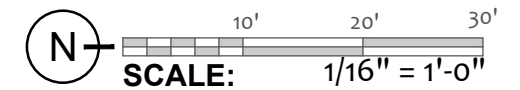

OWNER:

CLIENT:


-  360 Vantage Point (Web Link)
-  Still Photo
-  Red Flag Notification




FC NAME:	---
FCID:	N/A
FC ADDRESS:	---

FIELD SURVEYOR:	---
PROJECT DIRECTOR:	---
CHECKED BY:	---
DATE COMPLETED:	05/03/2022

PROJECT NUMBER:		####
SHEET:		A001.3
DRAWING NUMBER:	OF:	5 24
DRAWING NAME:		360 Mezzanine Fl. Plan

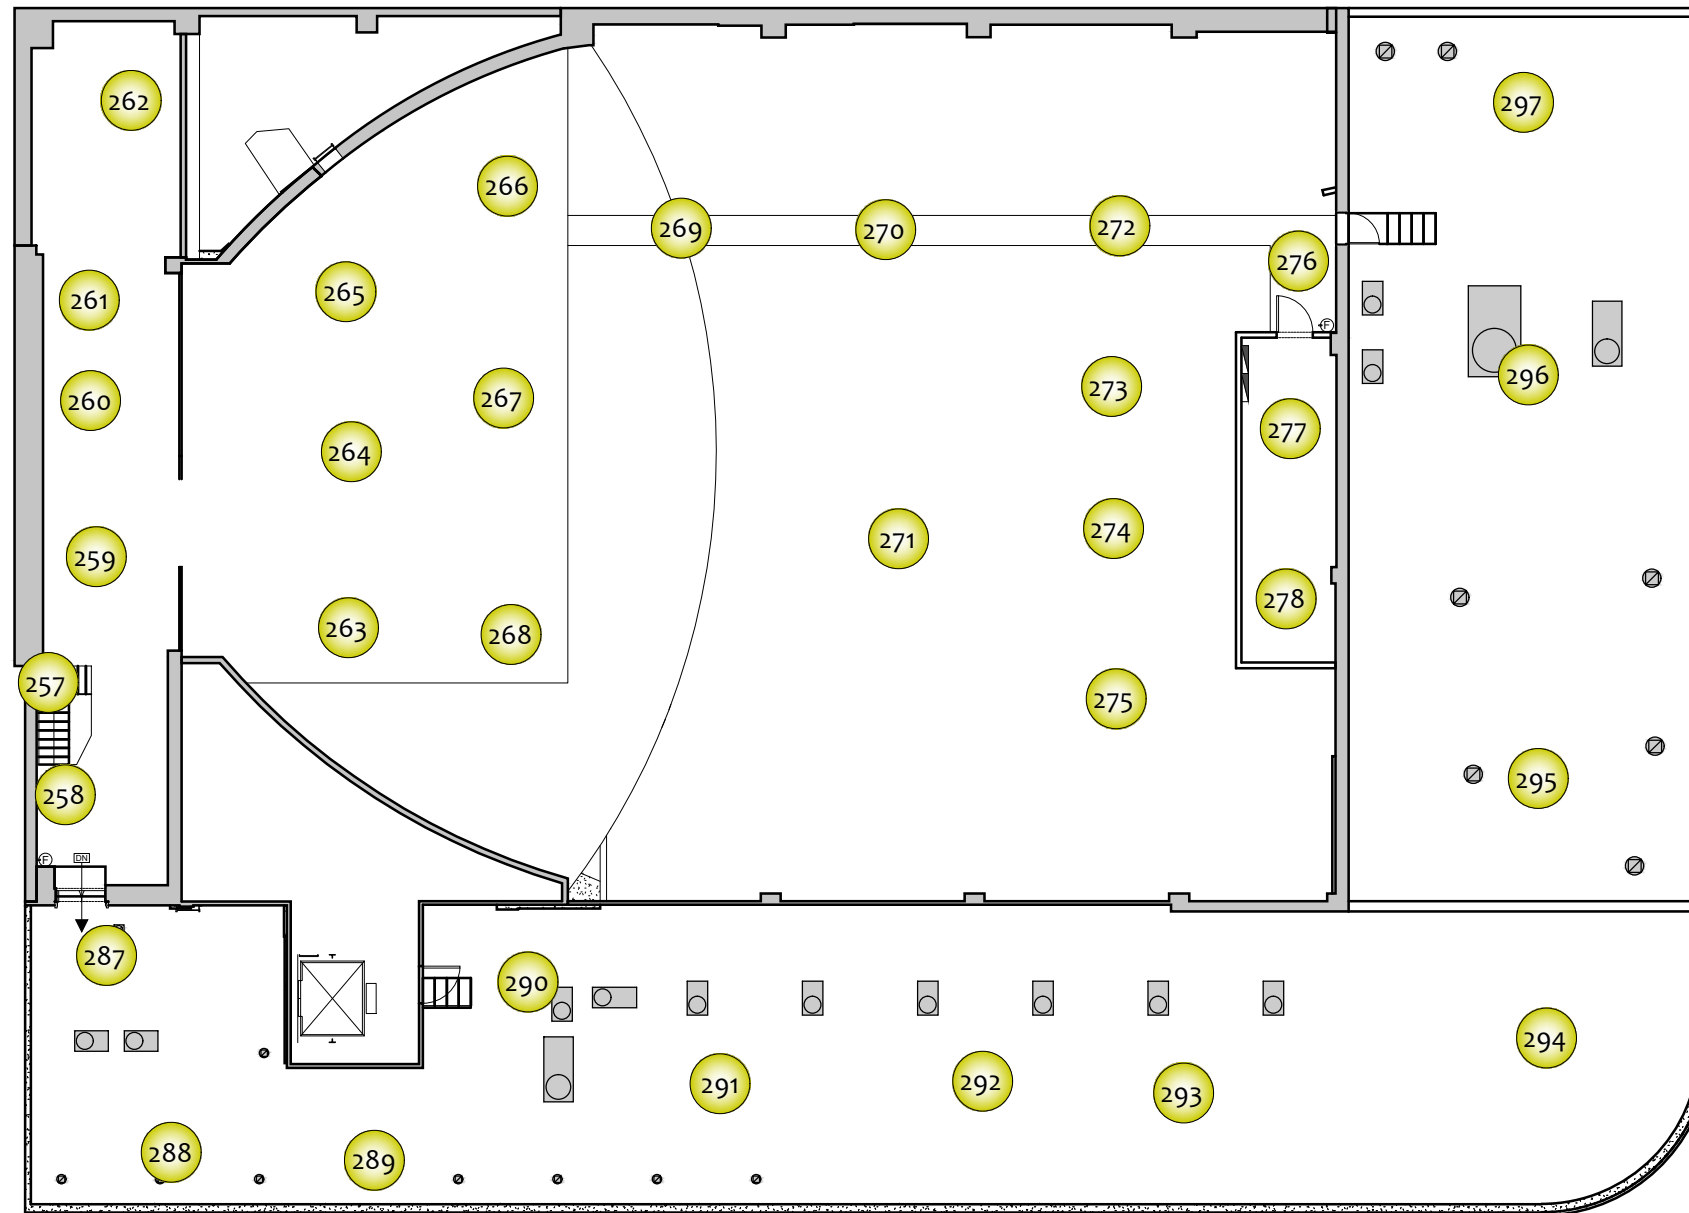

FLOOR GROSS SF: 8,432

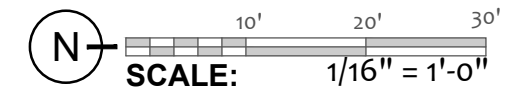

OWNER: CLIENT:

- 360 Vantage Point (Web Link)
- Still Photo
- Red Flag Notification




Arktech Solutions LLC.
10804 Inside Loop
Orlando, FL 32825
tel: (407) 205-7787
www.ArktechSolution.com


FC NAME:	---
FCID:	N/A
FC ADDRESS:	---

FIELD SURVEYOR:	---
PROJECT DIRECTOR:	---
CHECKED BY:	---
DATE COMPLETED:	05/03/2022

PROJECT NUMBER: #####	
SHEET: A001.4	
DRAWING NUMBER: 6	OF: 24
DRAWING NAME: 360 3rd Floor Plan	

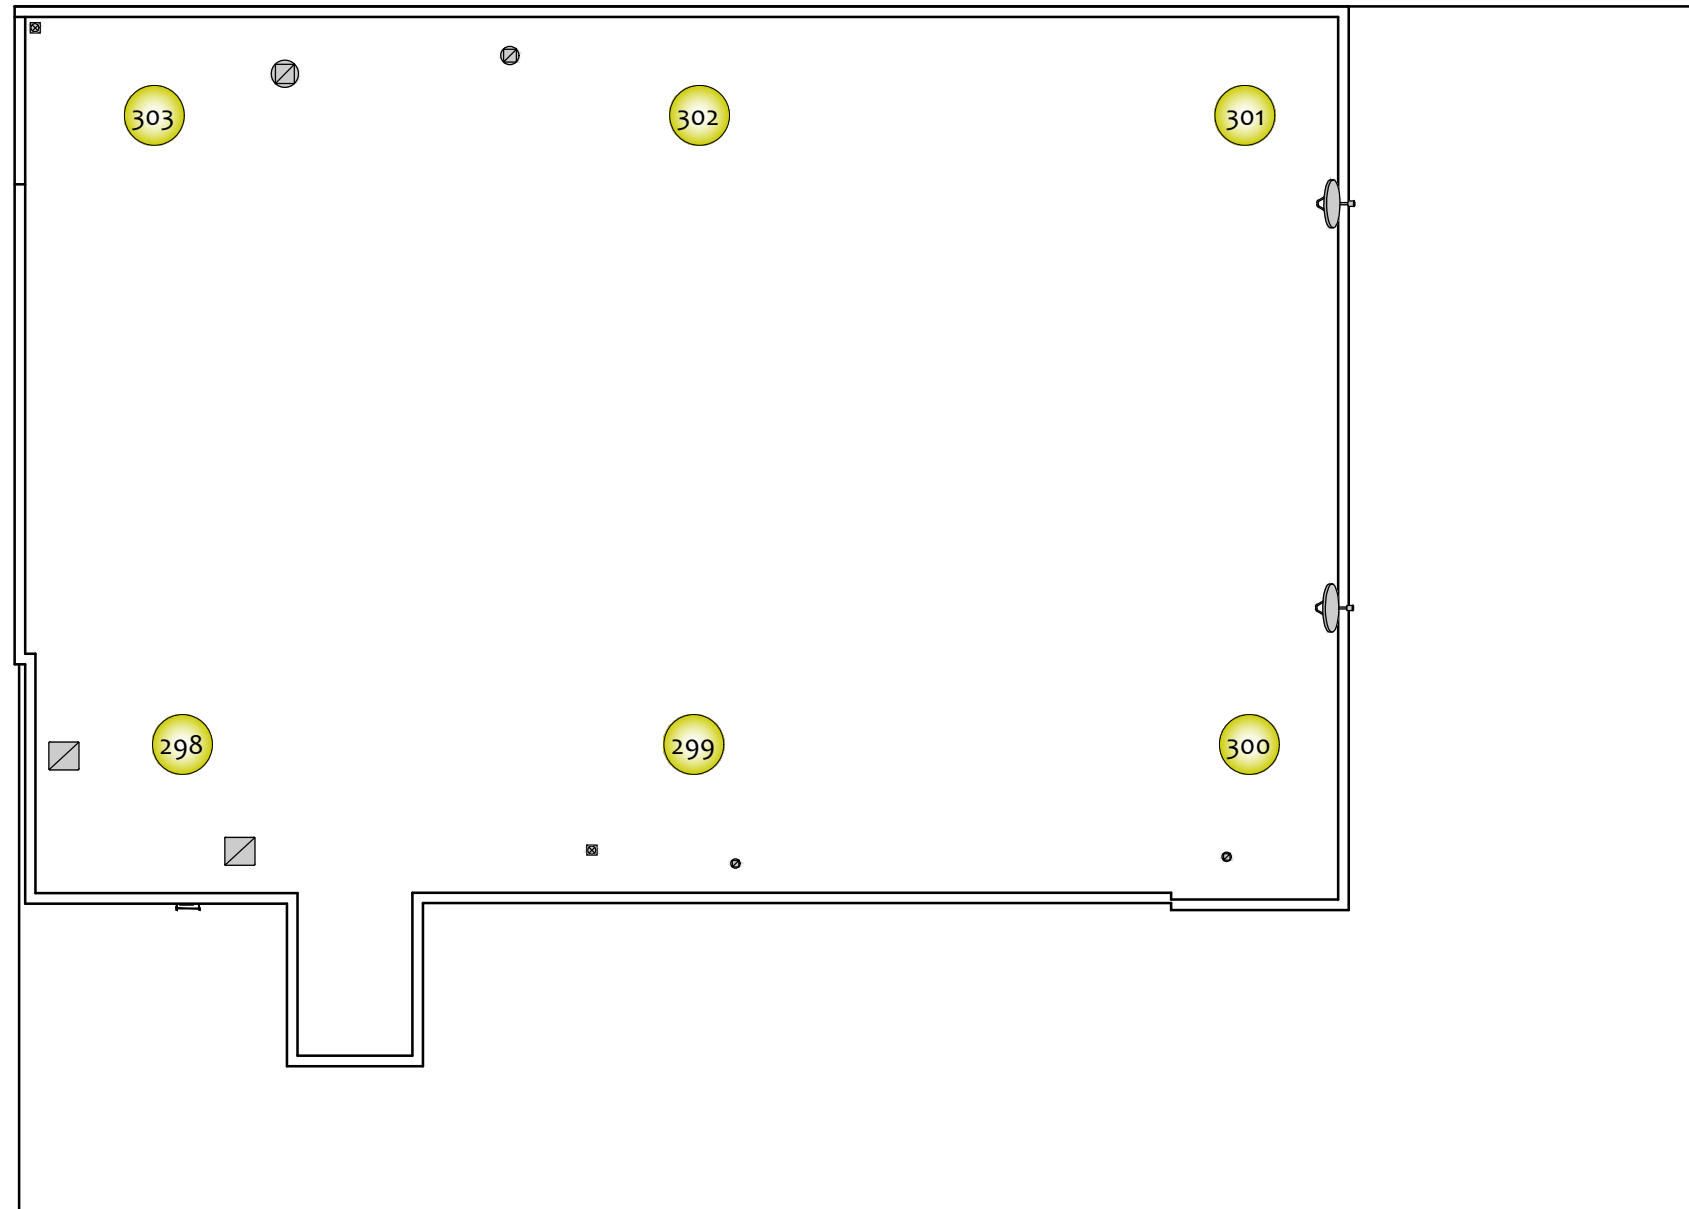

FLOOR GROSS SF:

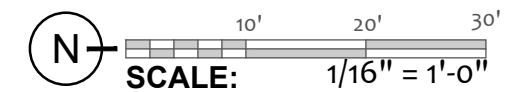

OWNER:

CLIENT:

- 360 Vantage Point (Web Link)
- Still Photo
- Red Flag Notification




Arktech Solutions LLC.
10804 Inside Loop
Orlando, FL 32825
tel: (407) 205-7787
www.ArktechSolution.com


FC NAME:	---
FCID:	N/A
FC ADDRESS:	---

FIELD SURVEYOR:	---
PROJECT DIRECTOR:	---
CHECKED BY:	---
DATE COMPLETED:	05/03/2022

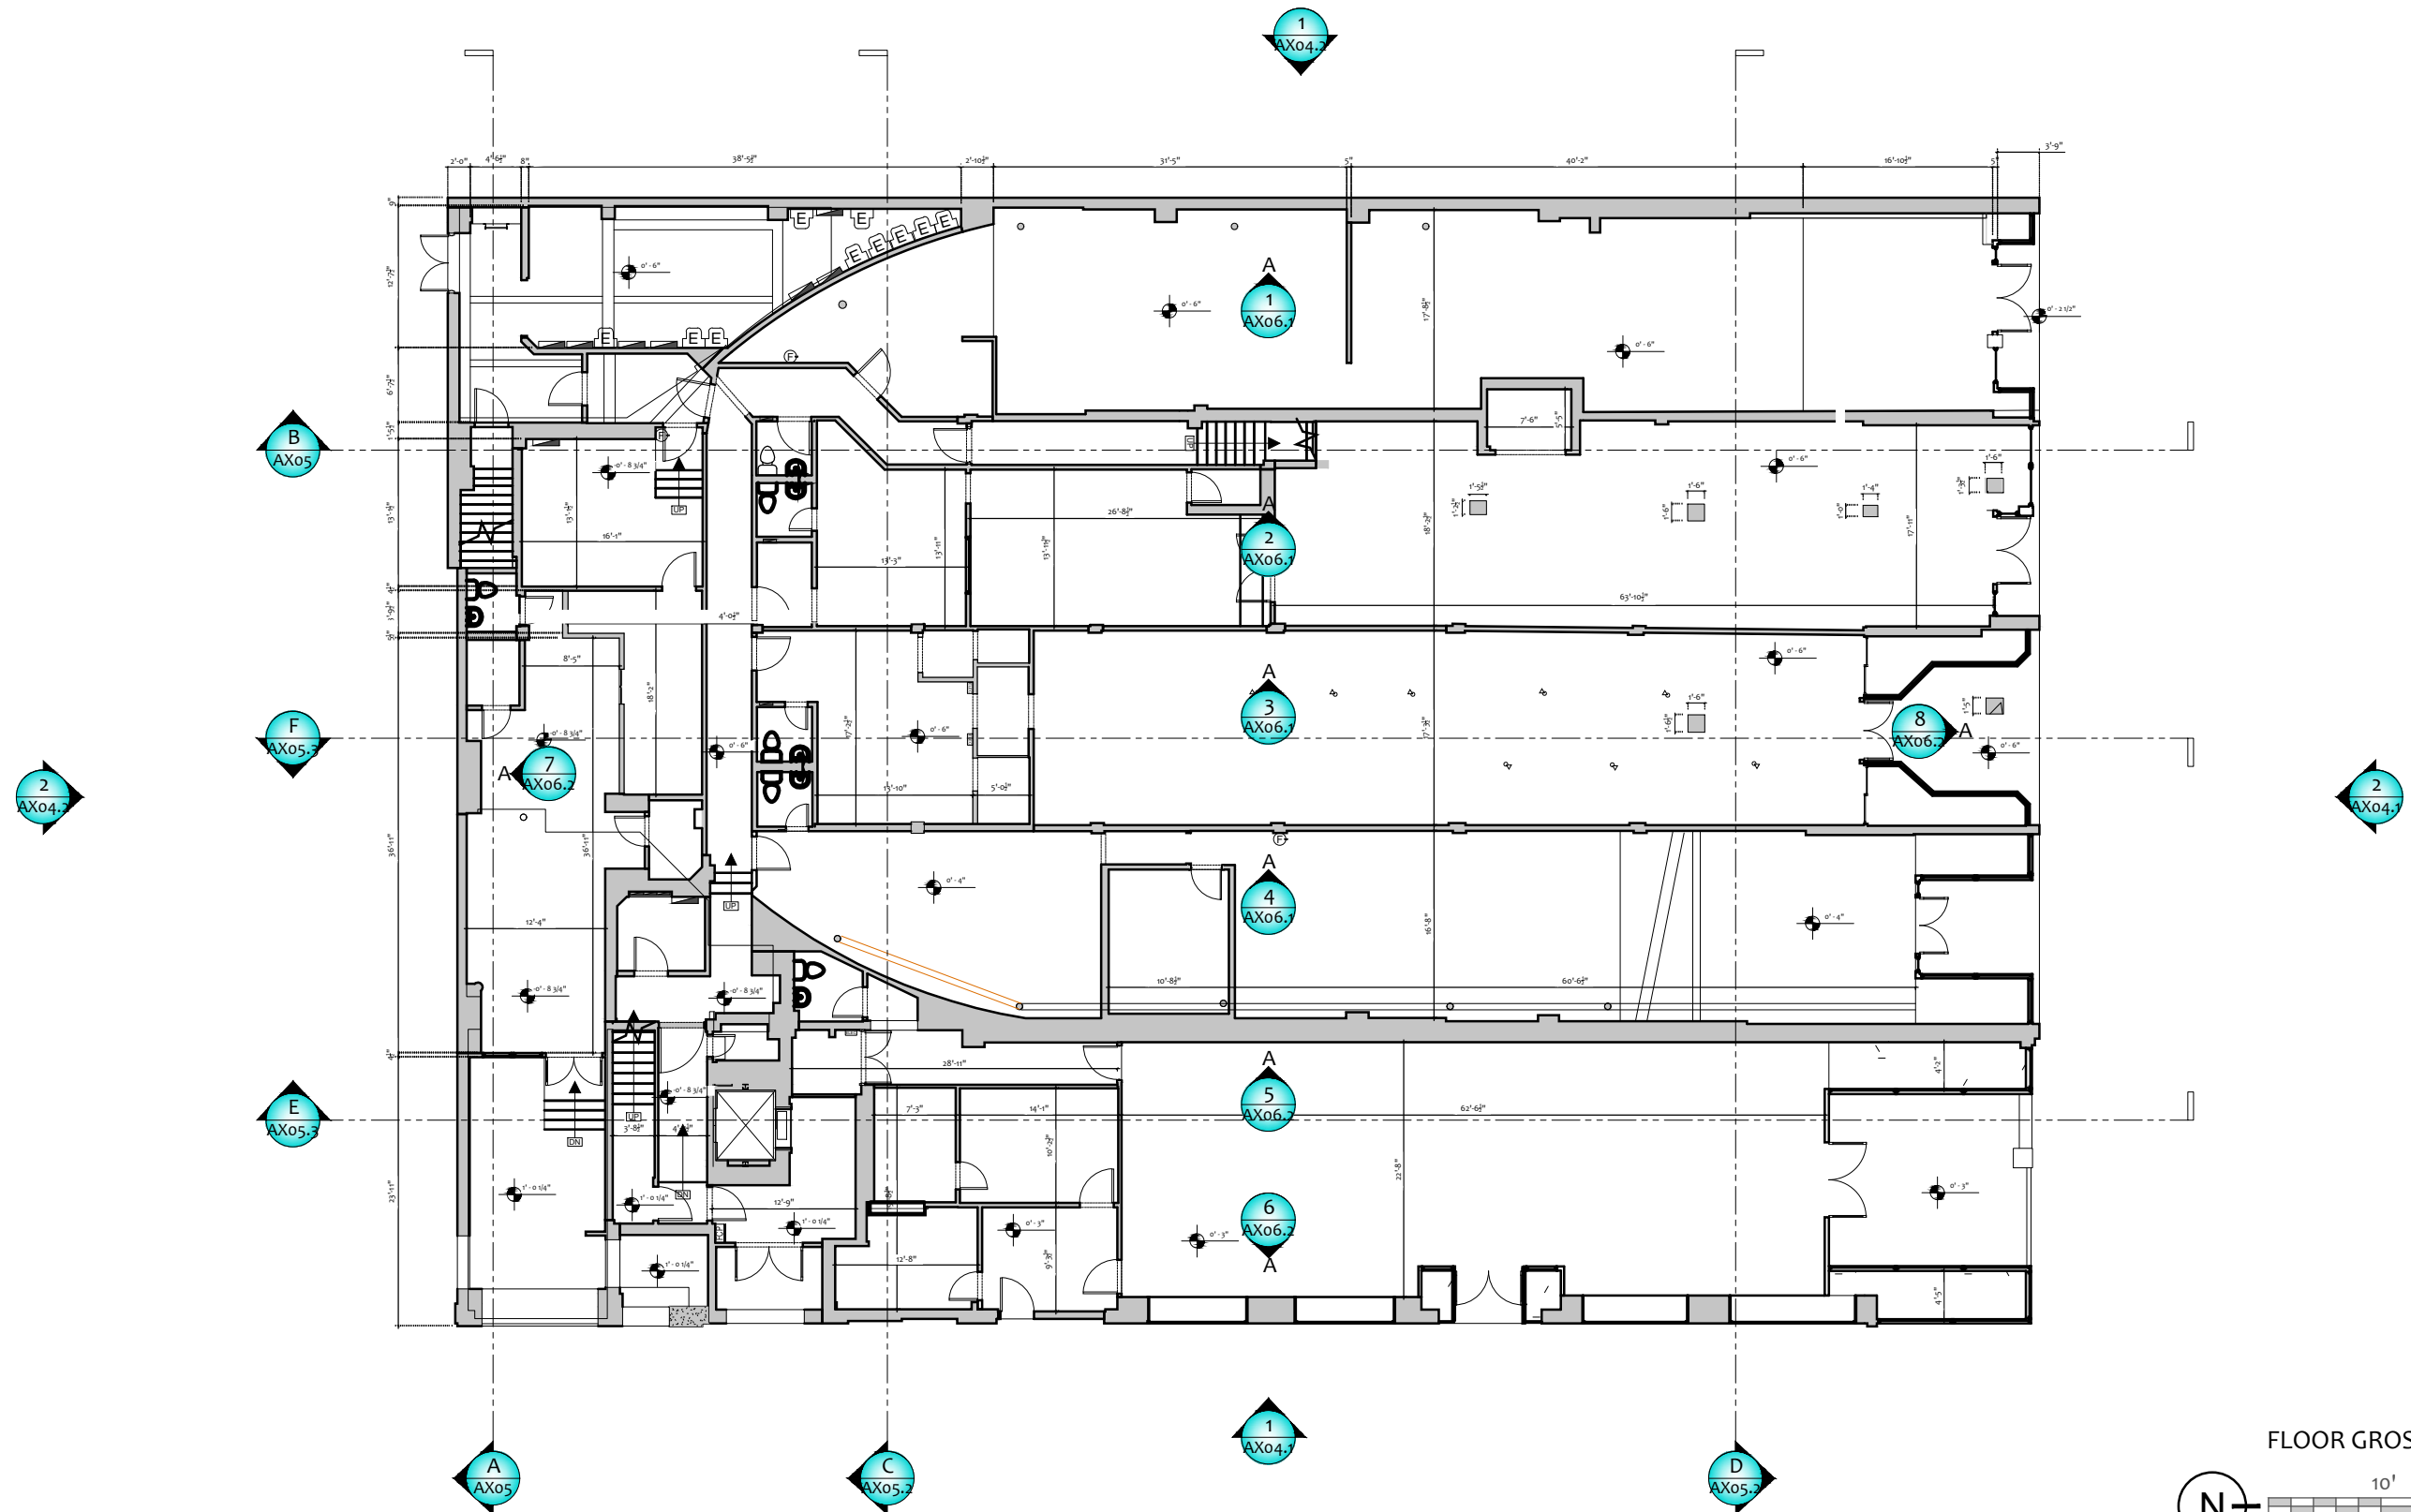

PROJECT NUMBER:		####
SHEET:		A001.5
DRAWING NUMBER:	OF:	7 24
DRAWING NAME:		360 Roof Floor Plan



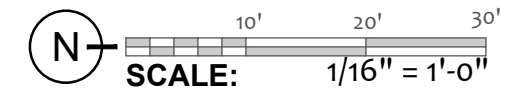



FLOOR GROSS SF: 14,148



OWNER: CLIENT:

-  BUILDING ENTRANCE
-  EMERGENCY/ ALARMED EXIT DOOR

-  ELEC PANEL - RECESSED
-  ELEC PANEL - SURFACE

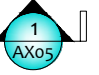-  SECTIONS
-  ELEVATIONS




FC NAME:	---
FCID:	N/A
FC ADDRESS:	---

FIELD SURVEYOR:	---
PROJECT DIRECTOR:	---
CHECKED BY:	---
DATE COMPLETED:	05/03/2022

PROJECT NUMBER:	####
SHEET:	A002.1
DRAWING NUMBER:	8
OF:	24
DRAWING NAME:	1st Floor Plan




FLOOR GROSS SF: 14,157

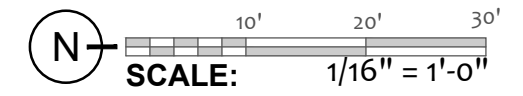

OWNER: CLIENT:


- ELEC PANEL - RECESSED
- ELEC PANEL - SURFACE

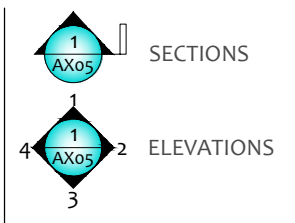


FC NAME:	---
FCID:	N/A
FC ADDRESS:	---

FIELD SURVEYOR:	---
PROJECT DIRECTOR:	---
CHECKED BY:	---
DATE COMPLETED:	05/03/2022

PROJECT NUMBER:	####
SHEET:	A002.2
DRAWING NUMBER:	9
OF:	24
DRAWING NAME:	2nd Floor Plan

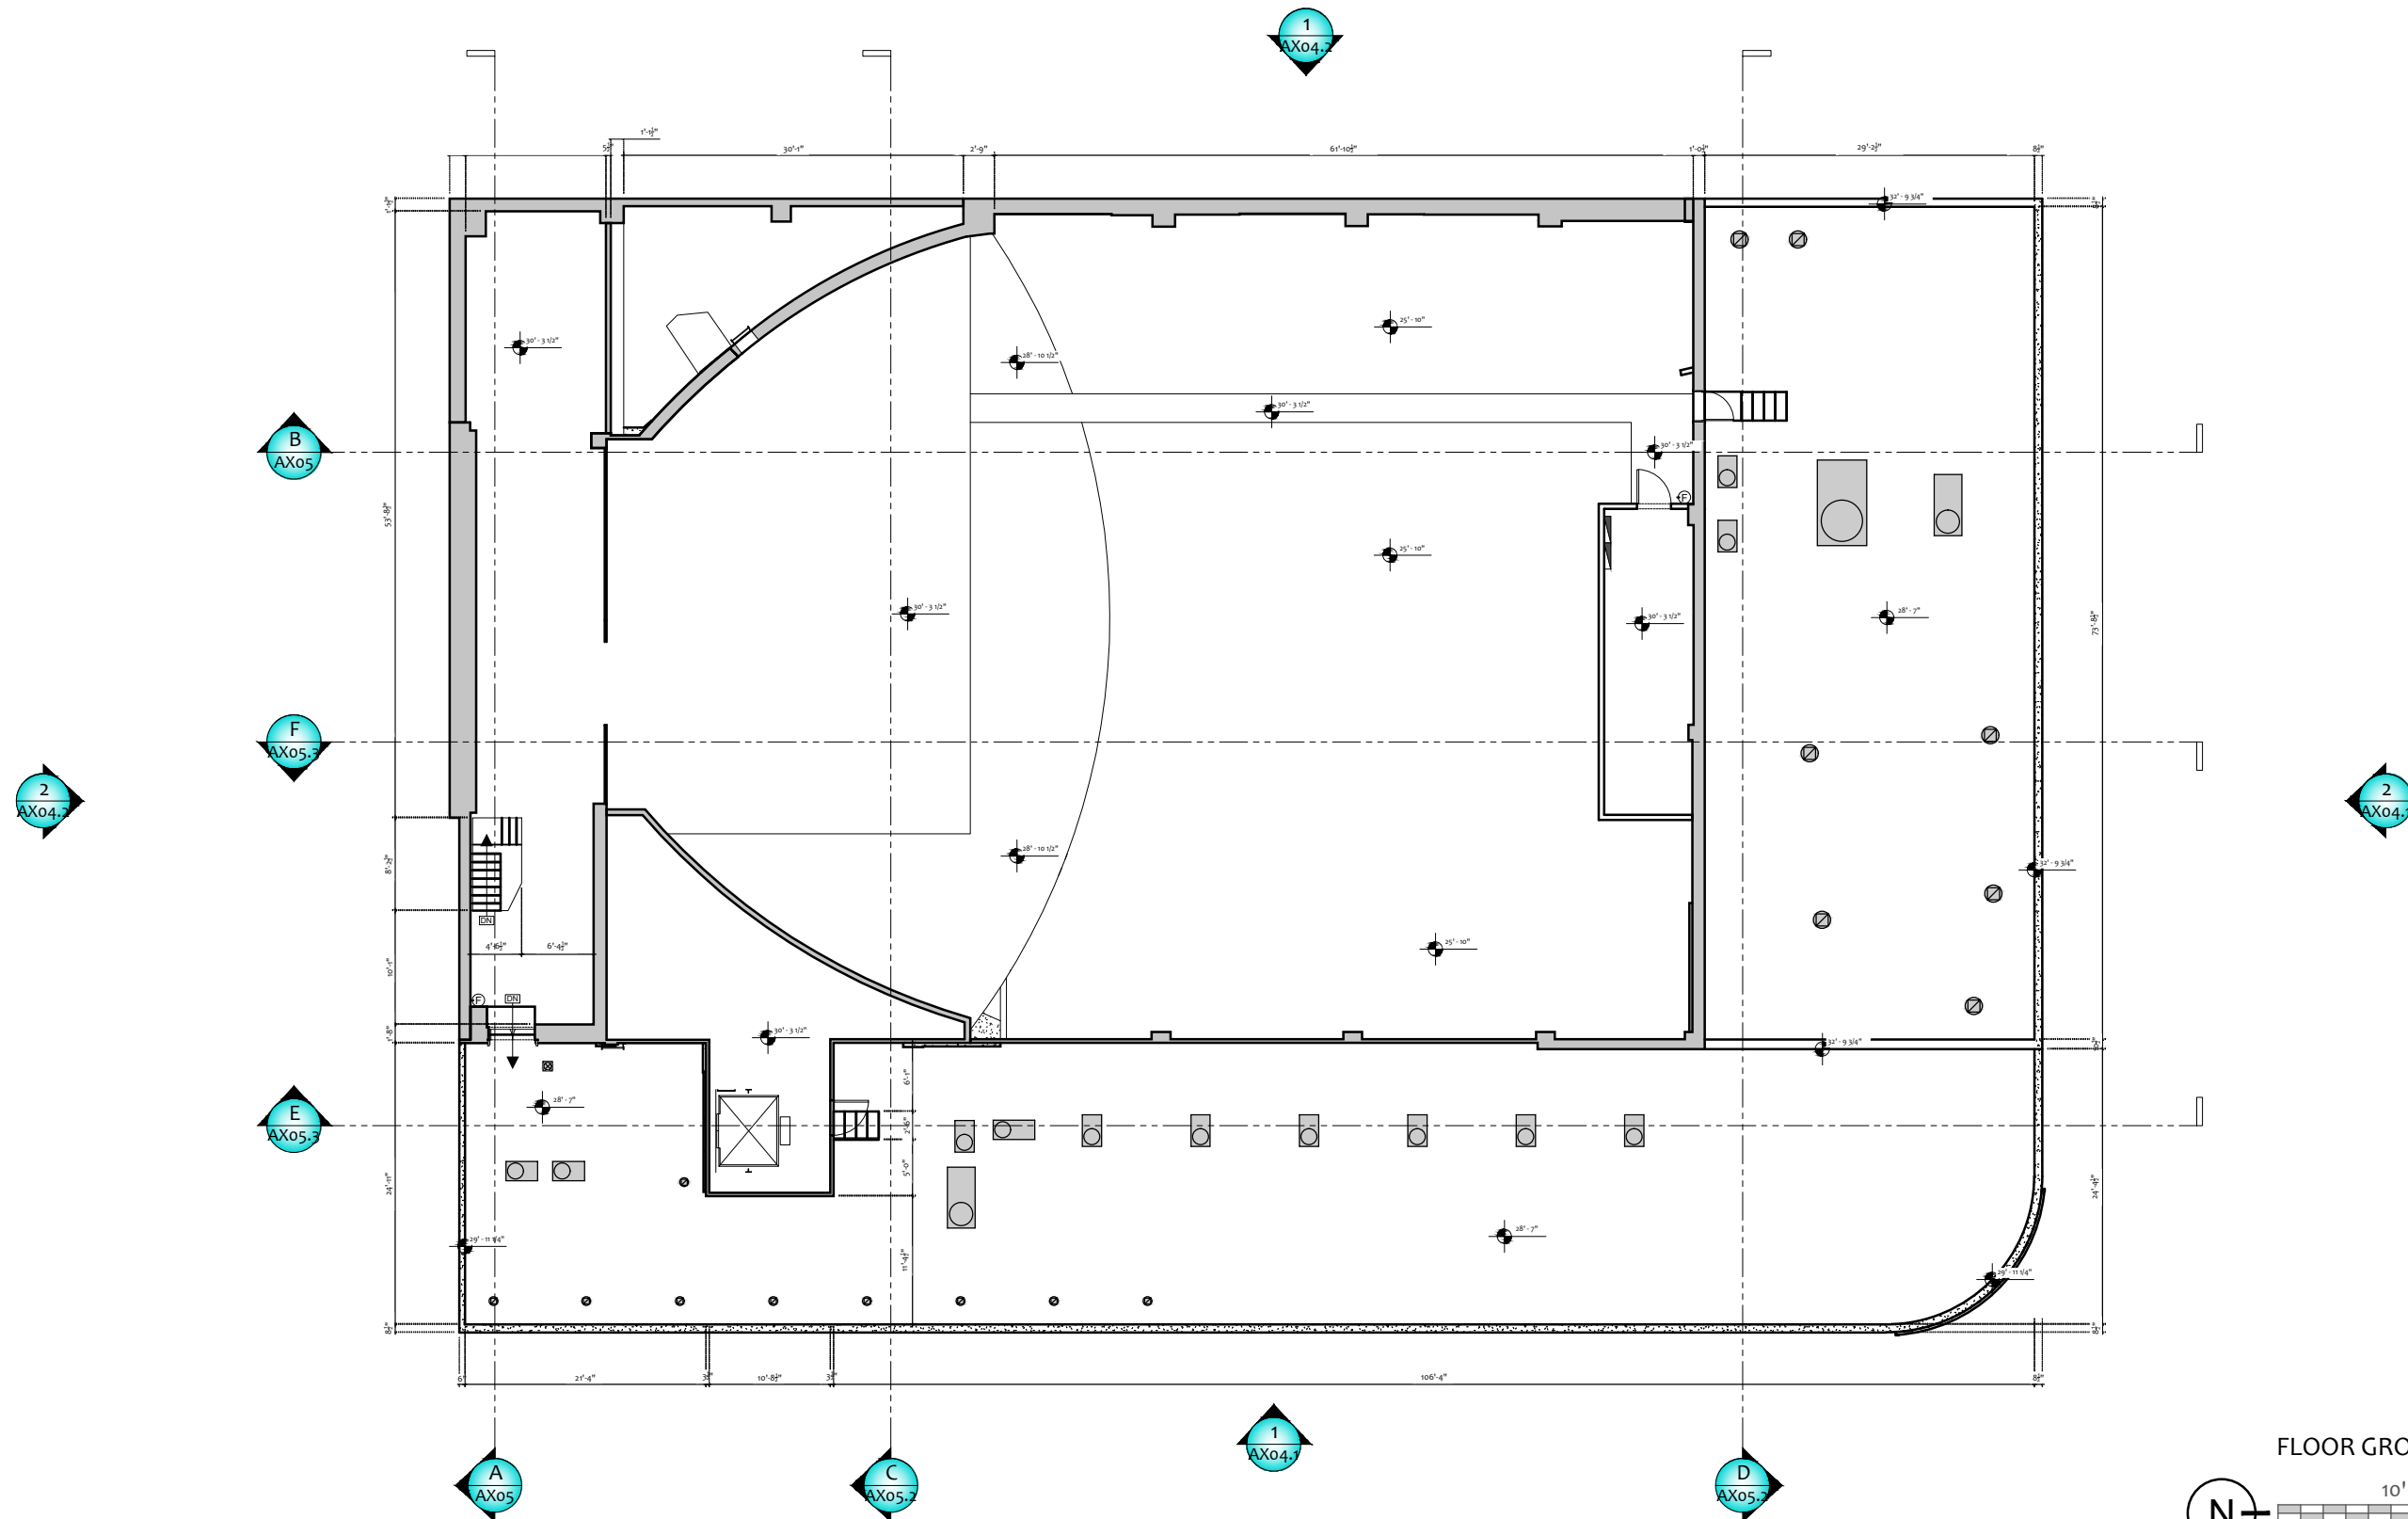


FLOOR GROSS SF: 8,432

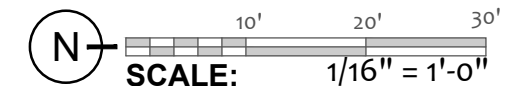

OWNER: CLIENT:

- ELEC PANEL - RECESSED
- ELEC PANEL - SURFACE

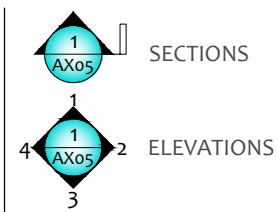


FC NAME:	---
FCID:	N/A
FC ADDRESS:	---

FIELD SURVEYOR:	---
PROJECT DIRECTOR:	---
CHECKED BY:	---
DATE COMPLETED:	05/03/2022



PROJECT NUMBER:	####
SHEET:	A002.4
DRAWING NUMBER:	11
OF:	24
DRAWING NAME:	3rd Floor Plan



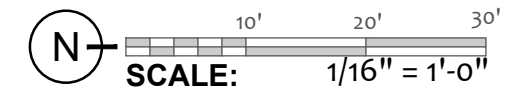



FLOOR GROSS SF: 14,148



OWNER: CLIENT:

-  BUILDING ENTRANCE
-  EMERGENCY/ ALARMED EXIT DOOR

-  ELEC PANEL - RECESSED
-  ELEC PANEL - SURFACE

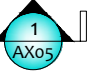
-  SECTIONS
-  ELEVATIONS




FC NAME:	---
FCID:	N/A
FC ADDRESS:	---

FIELD SURVEYOR:	---
PROJECT DIRECTOR:	---
CHECKED BY:	---
DATE COMPLETED:	05/03/2022

PROJECT NUMBER:	####
SHEET:	A002.1
DRAWING NUMBER:	12
OF:	24
DRAWING NAME:	1st Floor RCP Plan

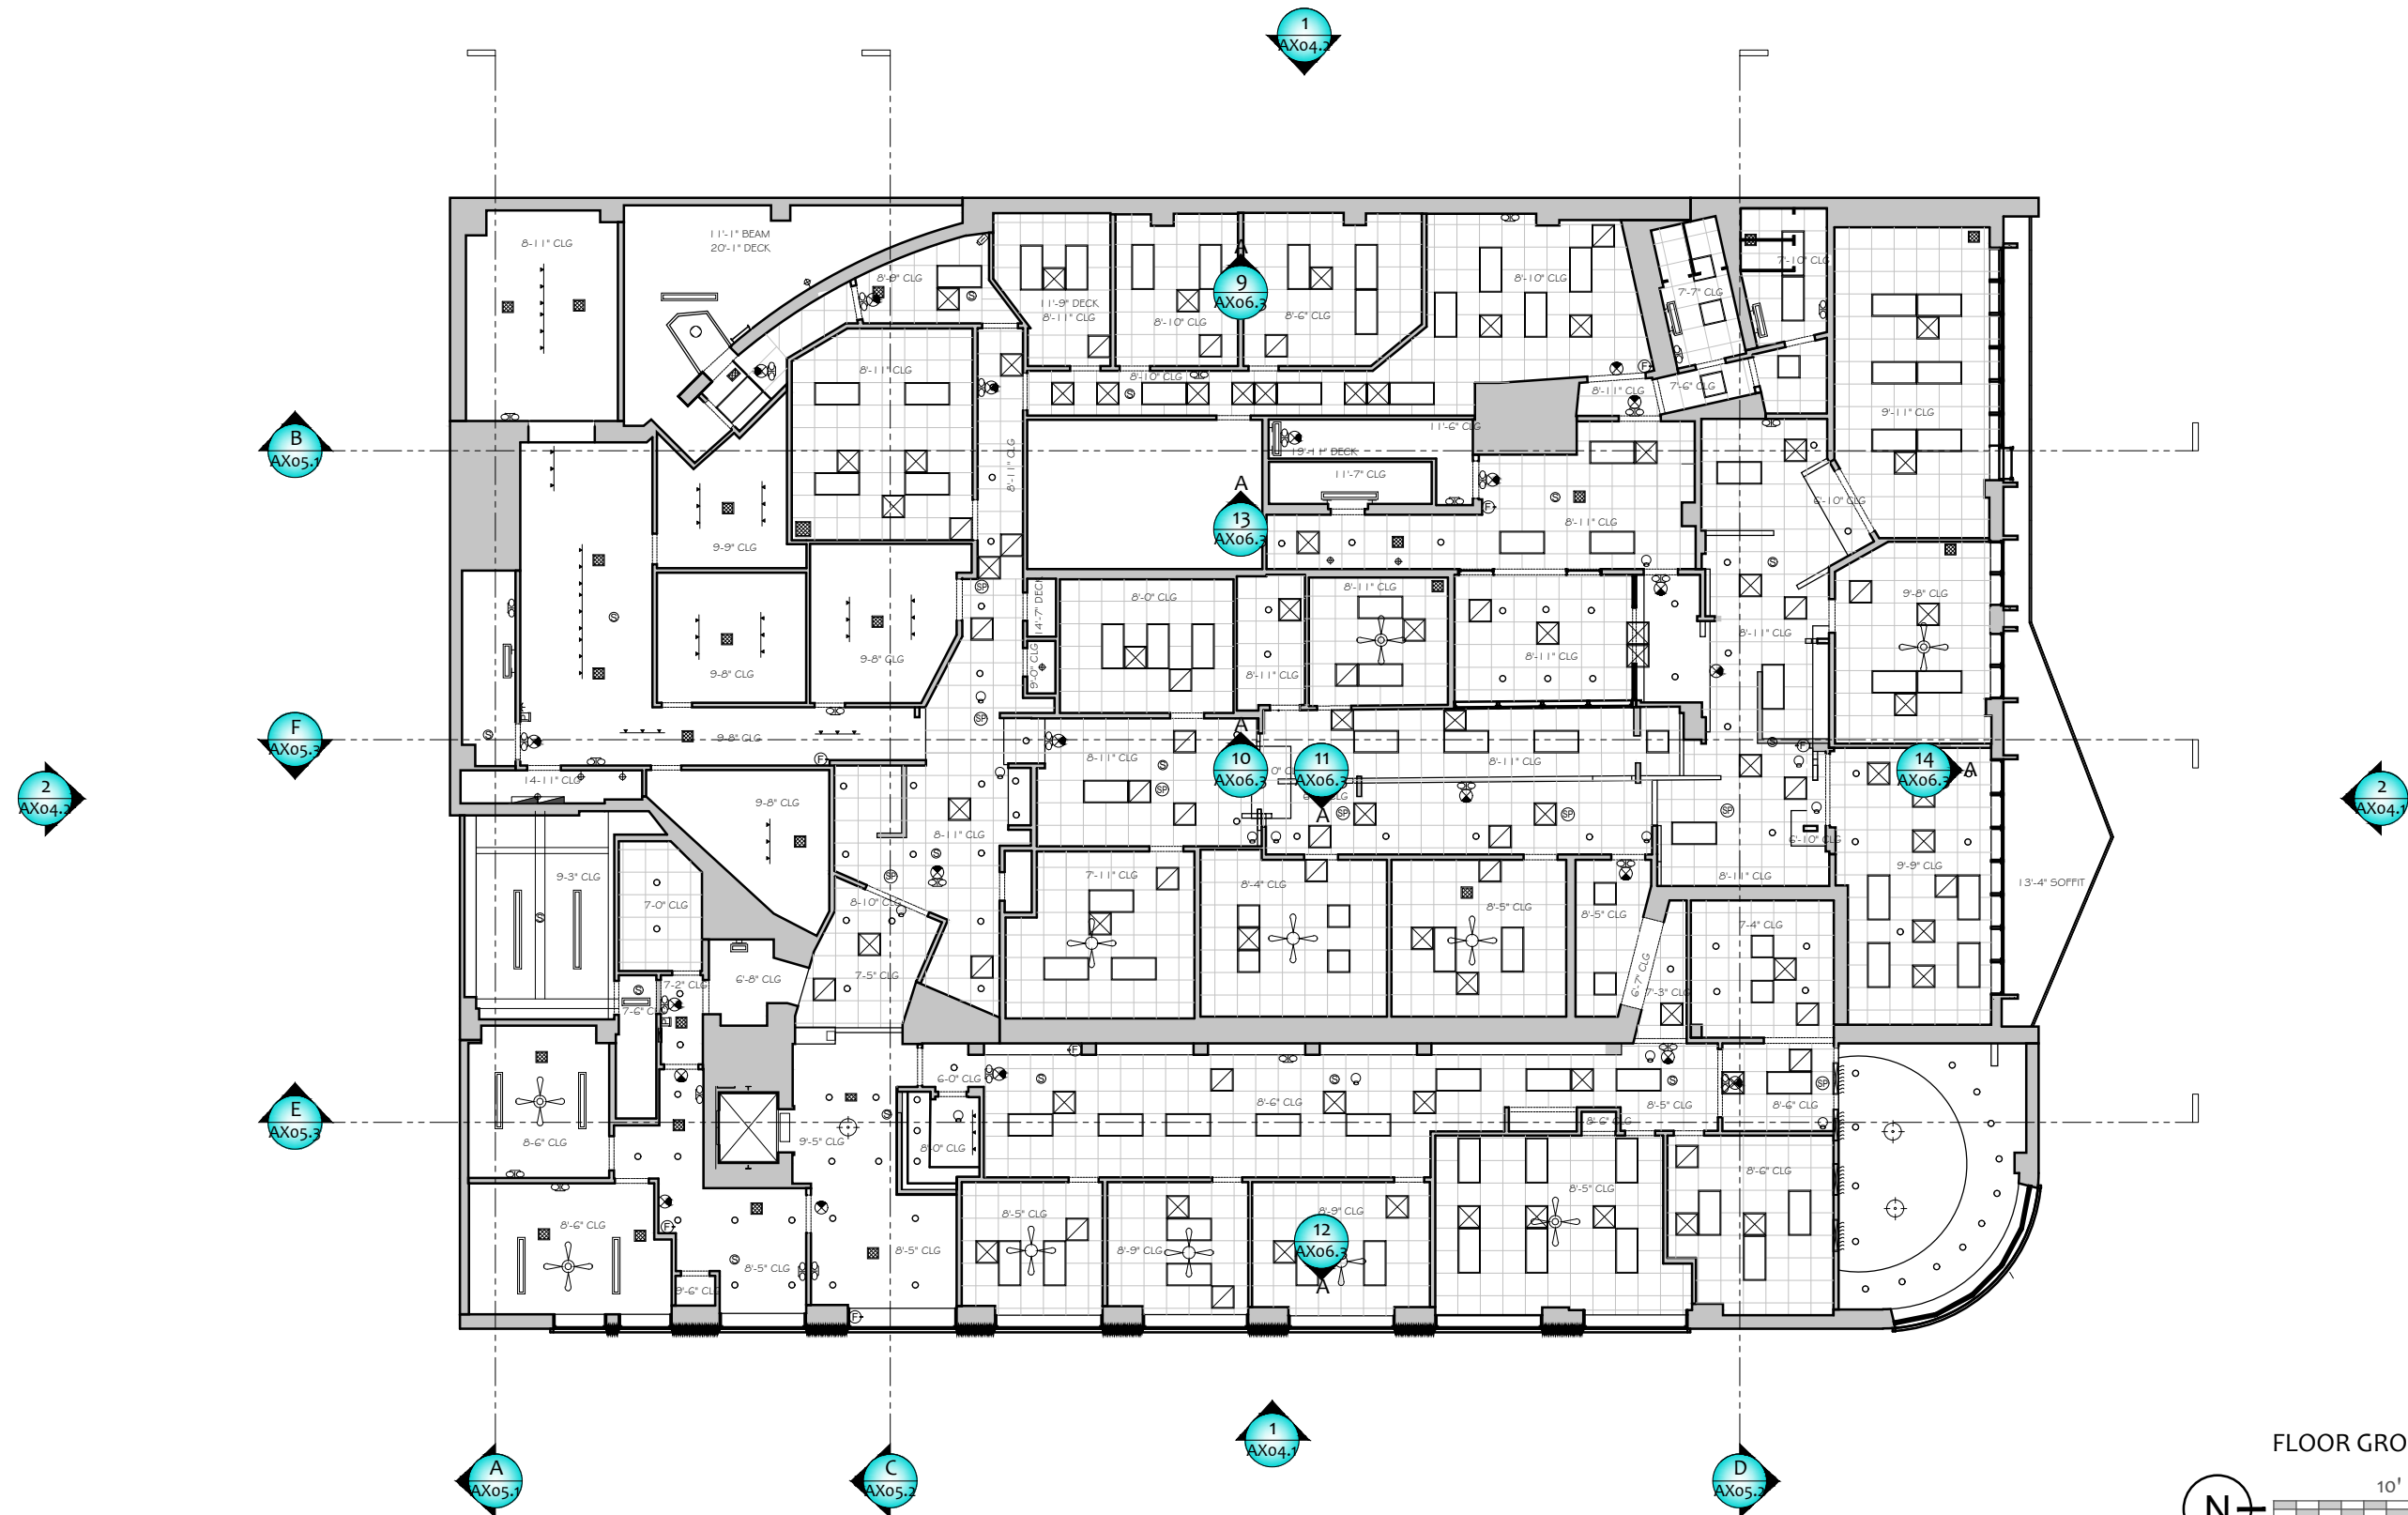


FLOOR GROSS SF: 14,157

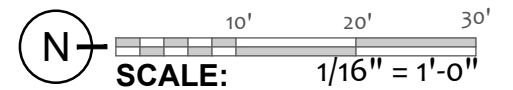

OWNER: CLIENT:

- ELEC PANEL - RECESSED
- ELEC PANEL - SURFACE

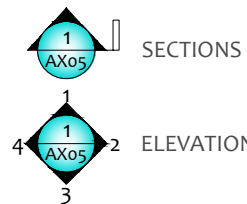


Arktech Solutions LLC.
10804 Inside Loop
Orlando, FL 32825
tel: (407) 205-7787
www.ArktechSolution.com


FC NAME:	---
FCID:	N/A
FC ADDRESS:	---

FIELD SURVEYOR:	---
PROJECT DIRECTOR:	---
CHECKED BY:	---
DATE COMPLETED:	05/03/2022


PROJECT NUMBER:	#####
SHEET:	A002.2
DRAWING NUMBER:	13
OF:	24
DRAWING NAME:	2nd Floor RCP Plan

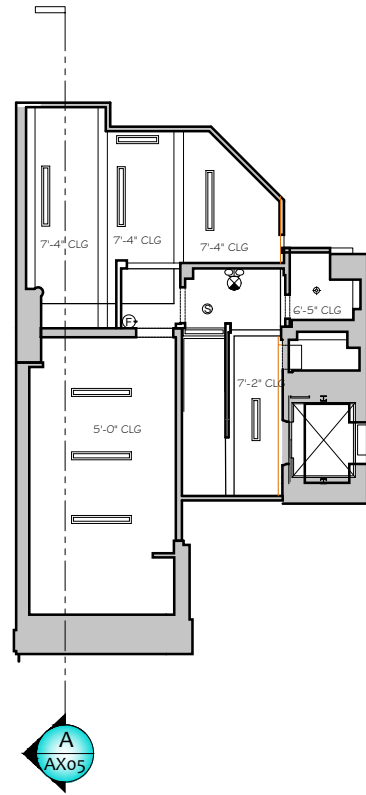

② MEZZANINE 1 FLOOR PLAN

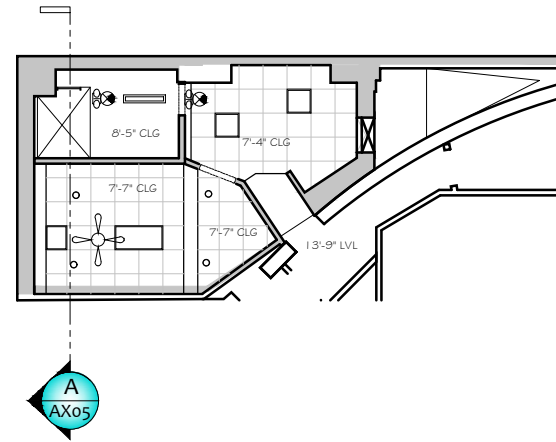


② MEZZANINE 2 FLOOR PLAN

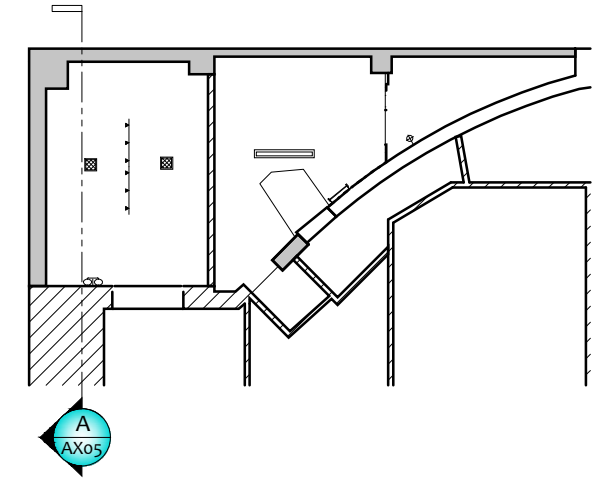

② MEZZANINE 3 FLOOR PLAN


FLOOR GROSS SF:

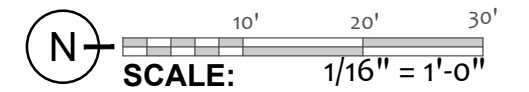

OWNER:

CLIENT:


- ELEC PANEL - RECESSED
- ELEC PANEL - SURFACE

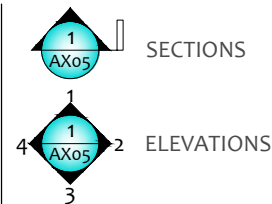


FC NAME:	---
FCID:	N/A
FC ADDRESS:	---

FIELD SURVEYOR:	---
PROJECT DIRECTOR:	---
CHECKED BY:	---
DATE COMPLETED:	05/03/2022

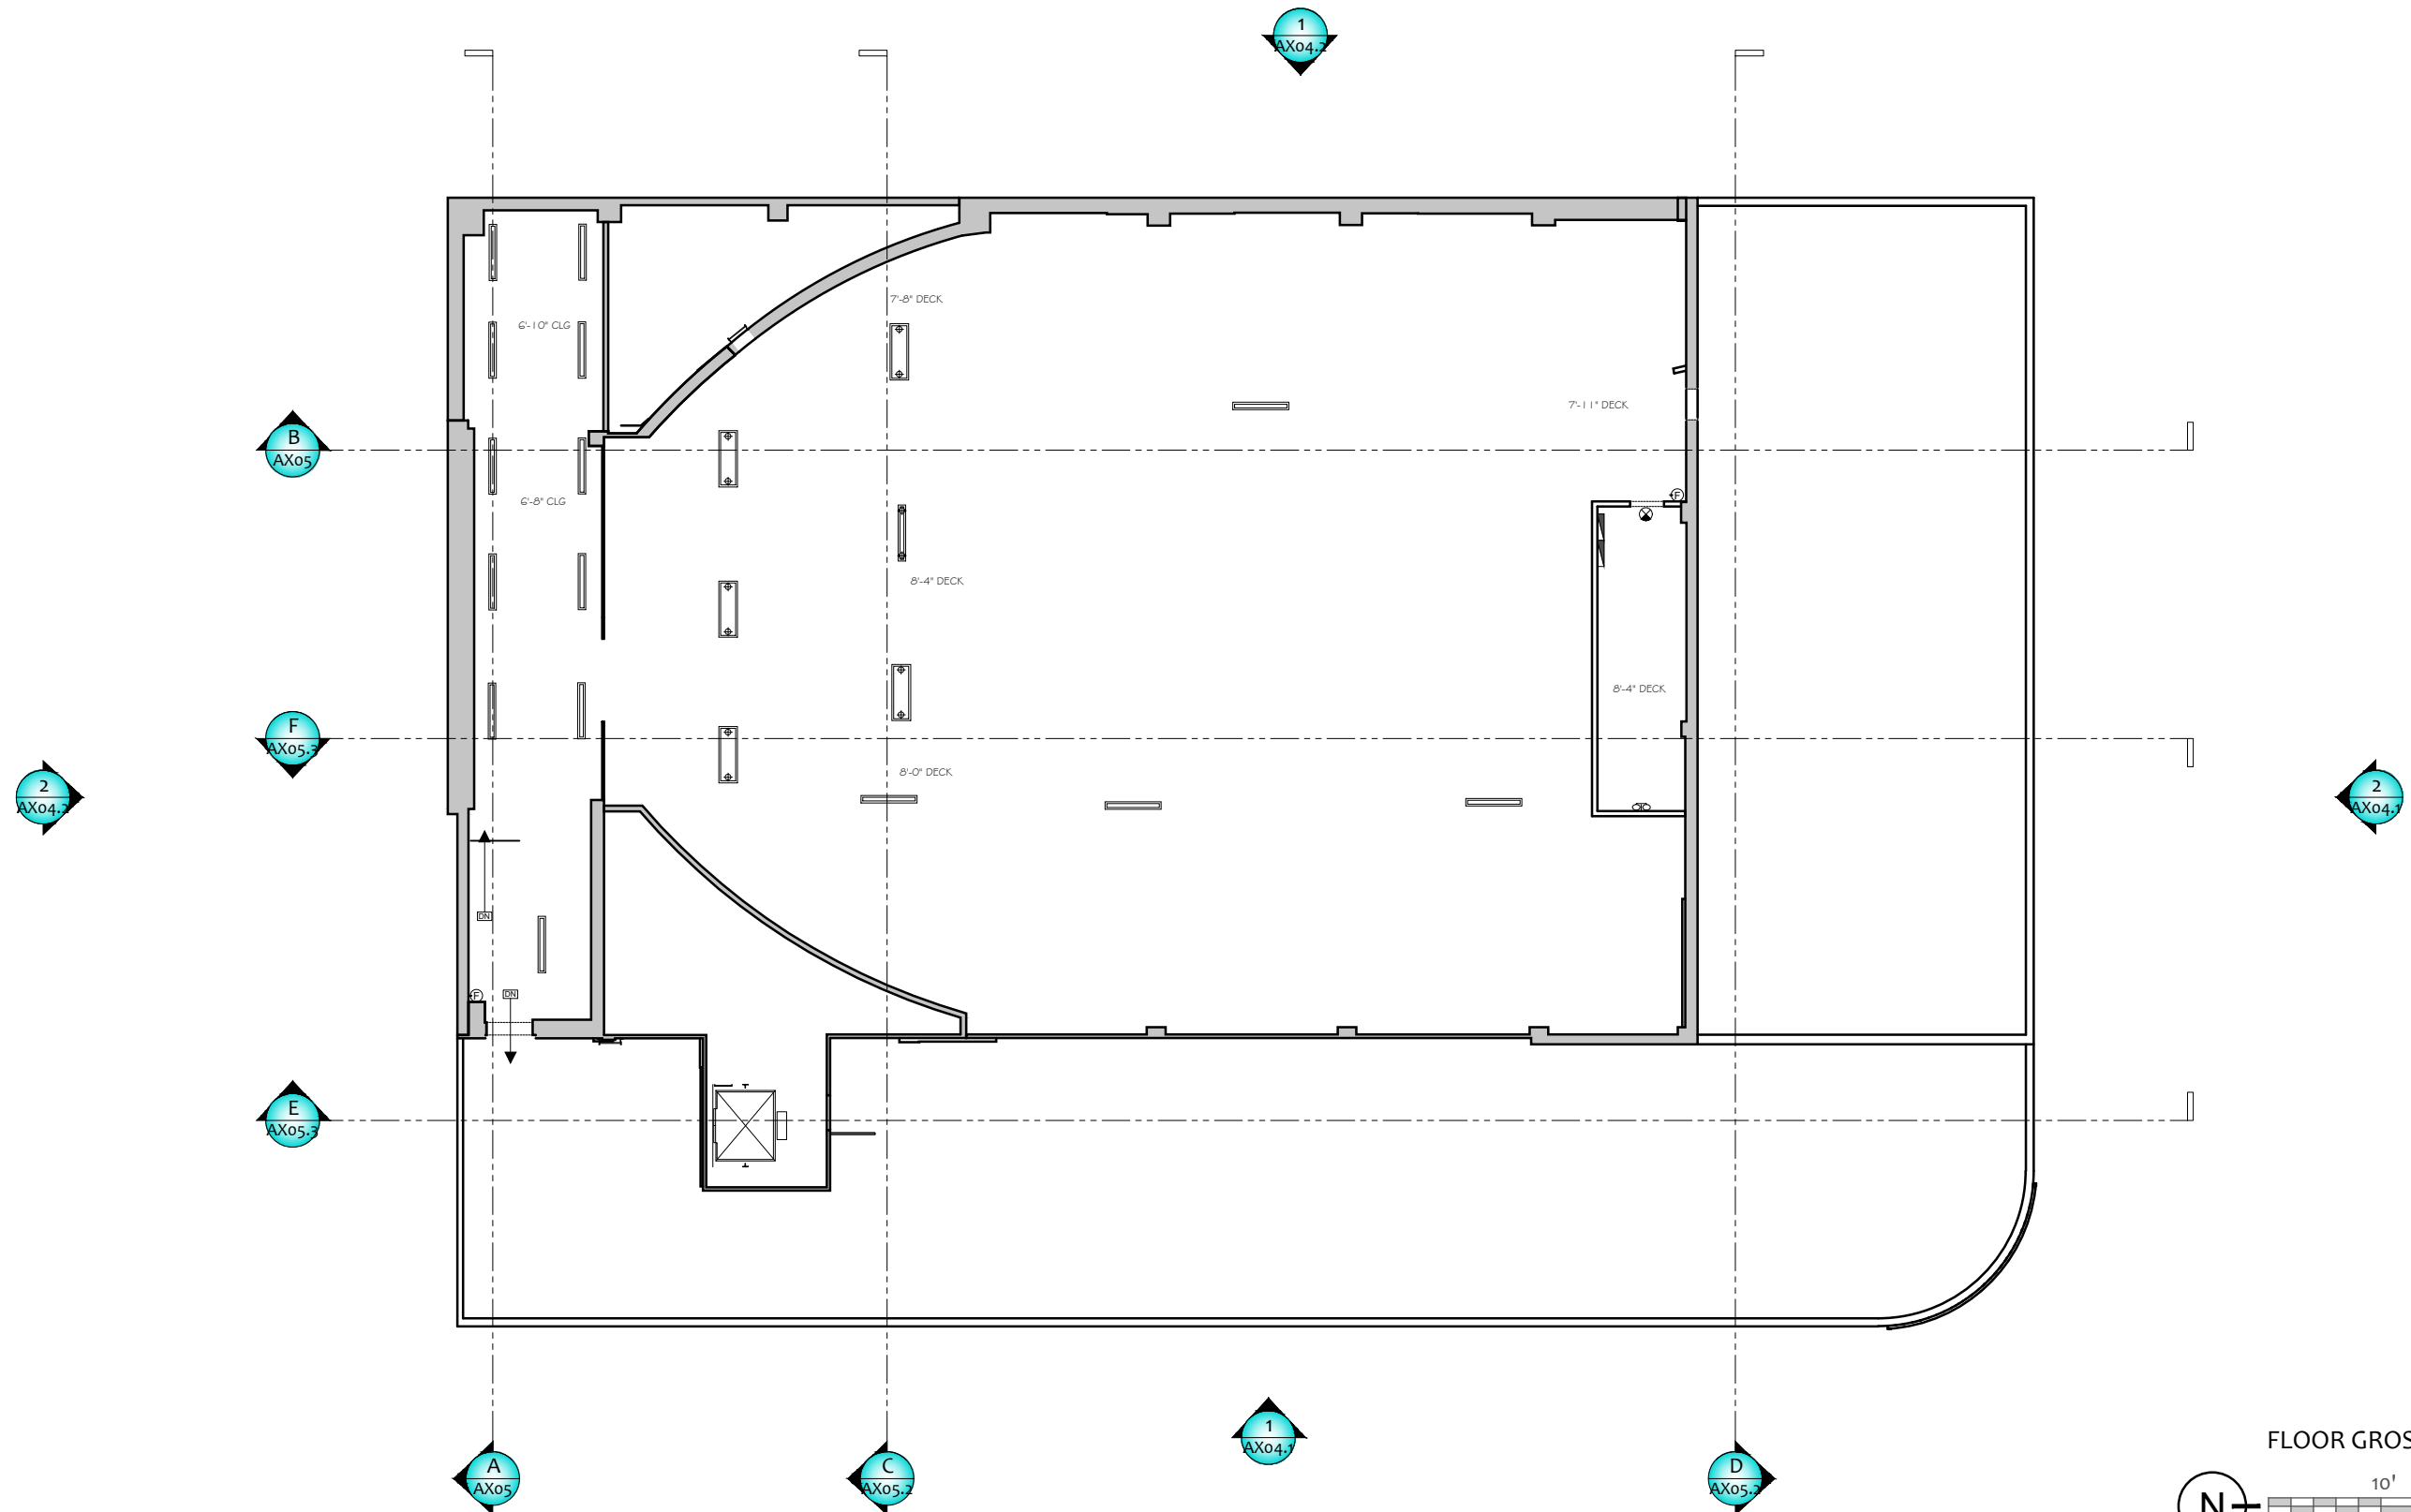

PROJECT NUMBER:	####
SHEET:	A002.3
DRAWING NUMBER:	14
OF:	24
DRAWING NAME:	Mezzanine RCP Plan

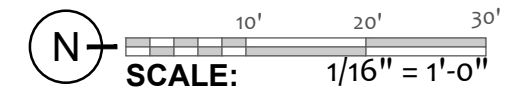


FLOOR GROSS SF: 8,432



OWNER: CLIENT:

-  ELEC PANEL - RECESSED
-  ELEC PANEL - SURFACE

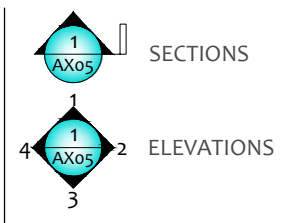



Arktech Solutions LLC.
10804 Inside Loop
Orlando, FL 32825
tel: (407) 205-7787
www.ArktechSolution.com

FC NAME:	---
FCID:	N/A
FC ADDRESS:	---



FIELD SURVEYOR:	---
PROJECT DIRECTOR:	---
CHECKED BY:	---
DATE COMPLETED:	05/03/2022

PROJECT NUMBER:	####
SHEET:	A002.4
DRAWING NUMBER:	15
OF:	24
DRAWING NAME:	3rd Floor RCP Plan

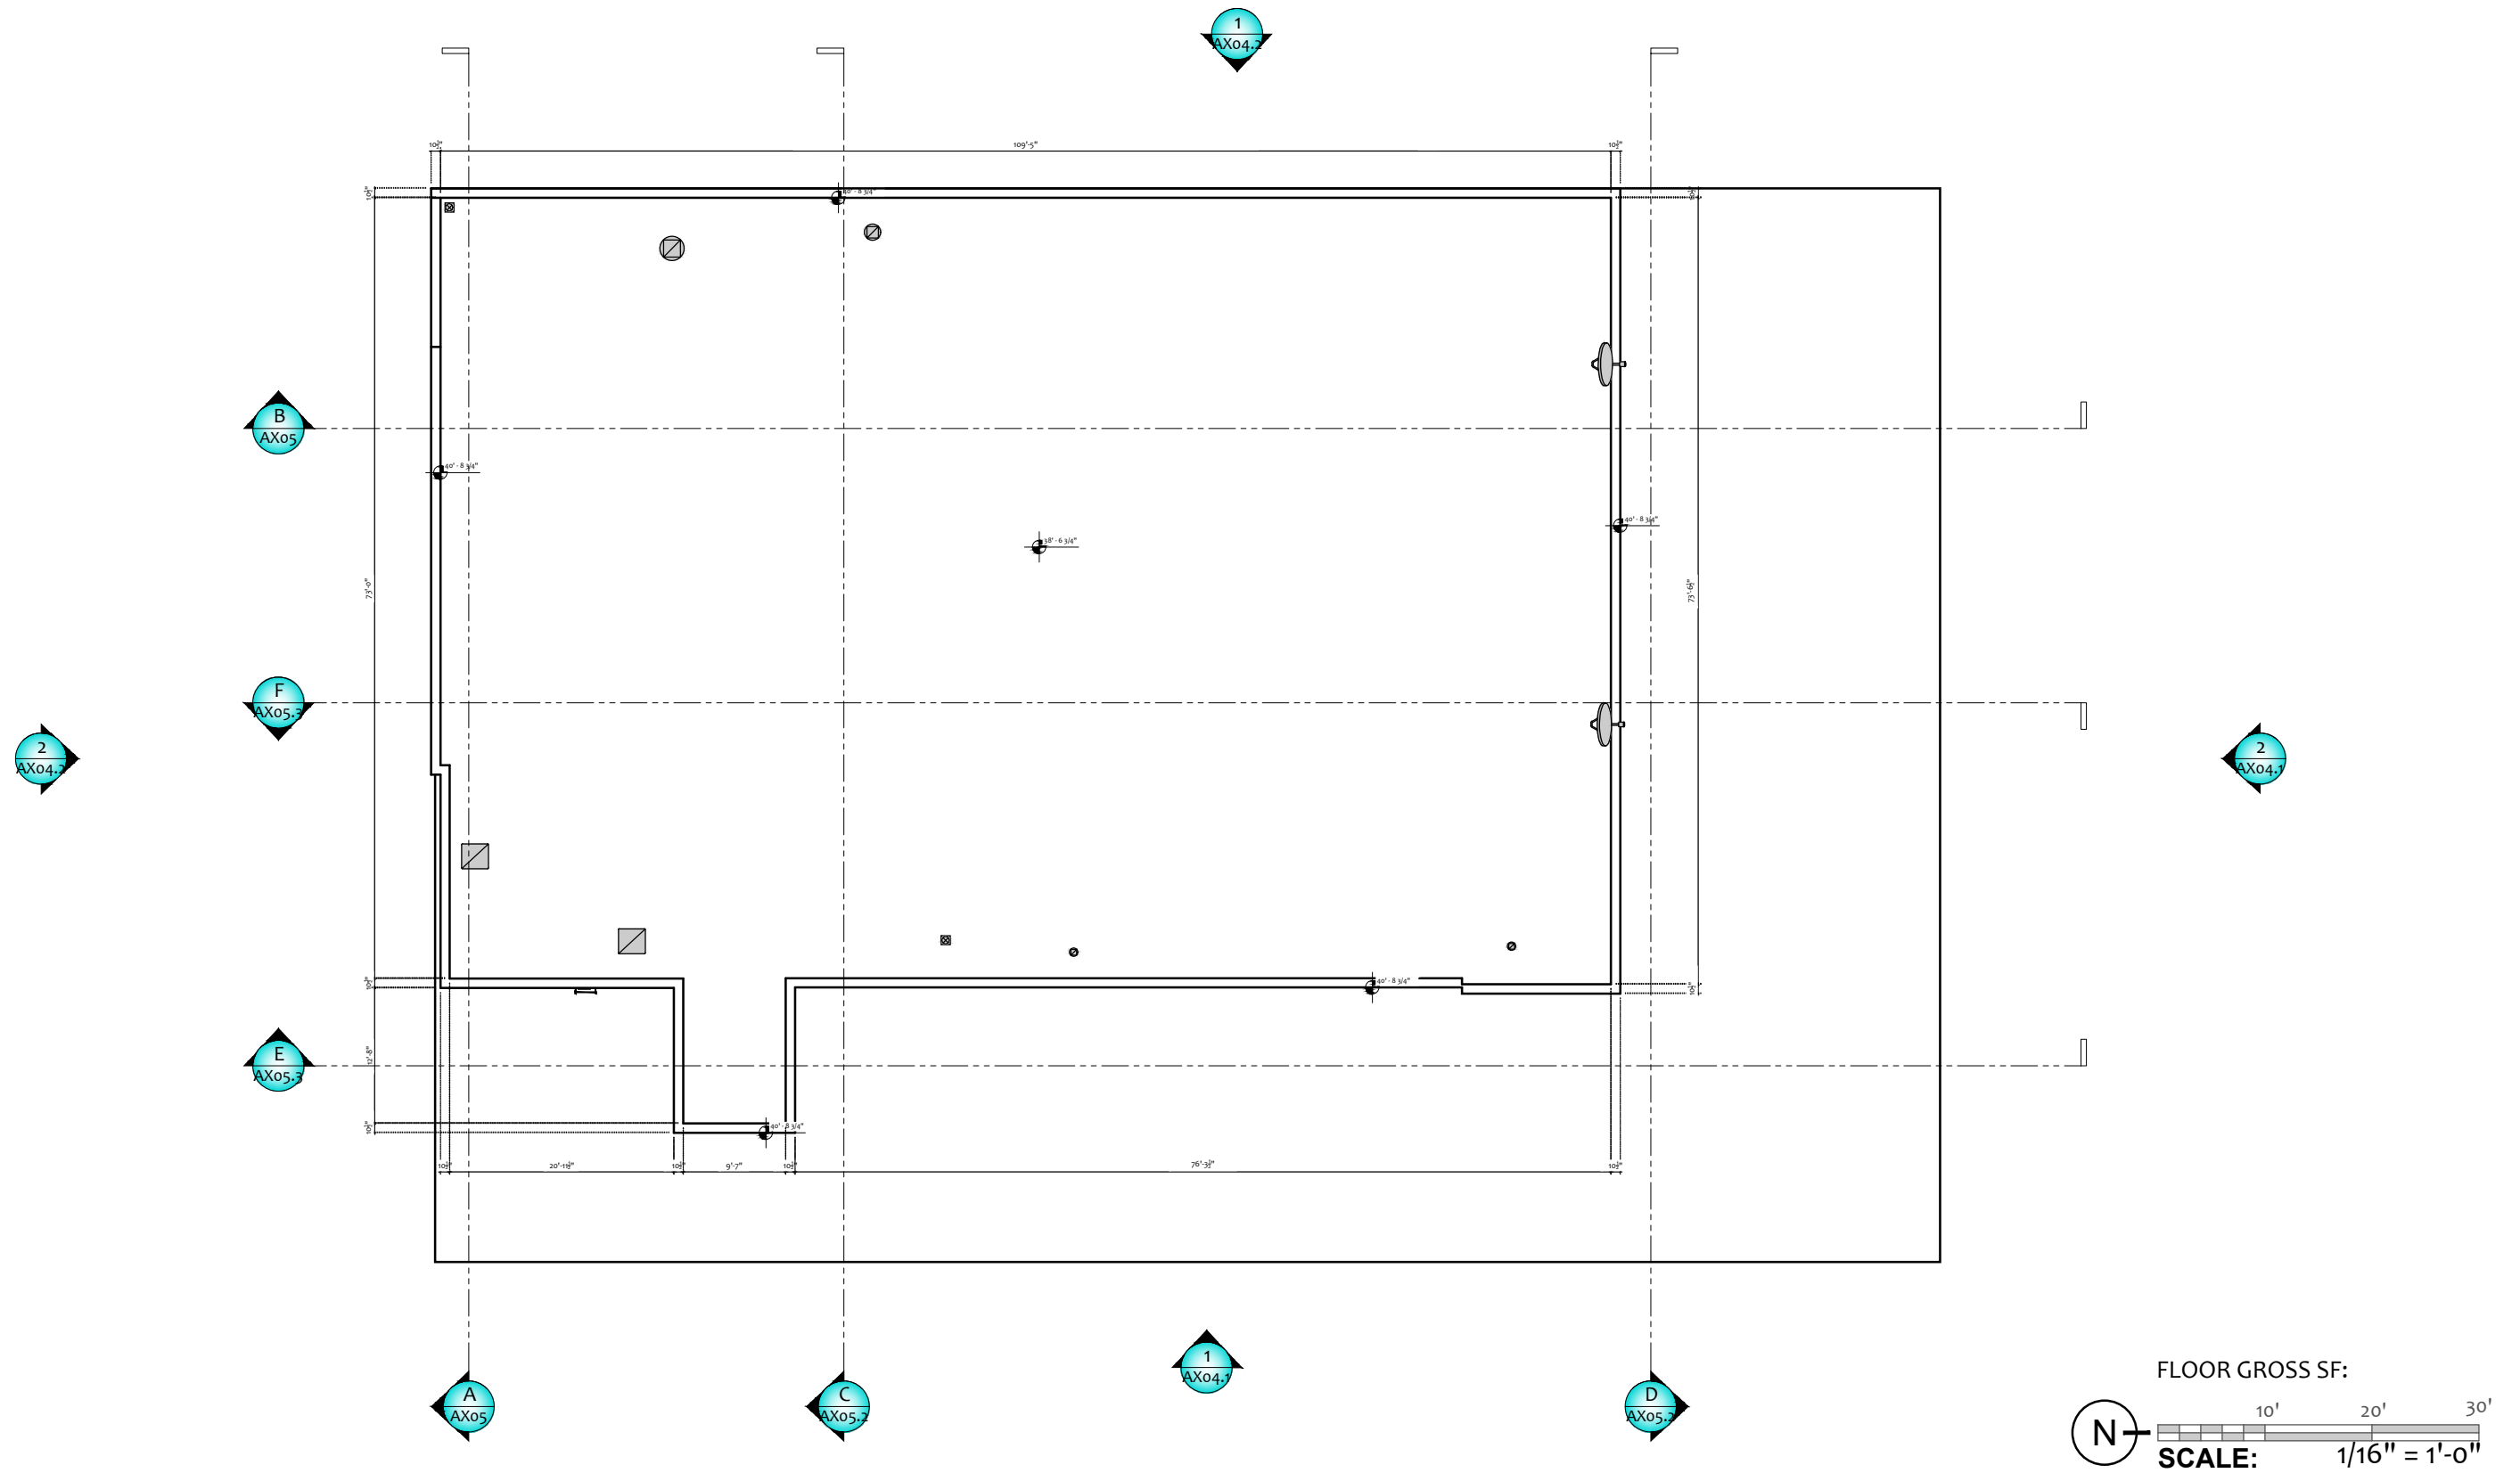

OWNER: CLIENT:


- ELEC PANEL - RECESSED
- ELEC PANEL - SURFACE

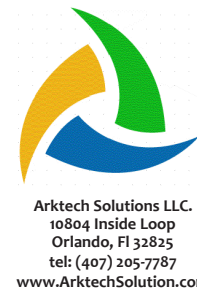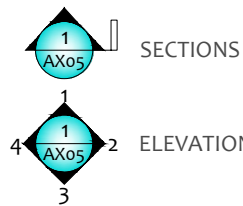


FC NAME:	---
FCID:	N/A
FC ADDRESS:	---

FIELD SURVEYOR:	---
PROJECT DIRECTOR:	---
CHECKED BY:	---
DATE COMPLETED:	05/03/2022

PROJECT NUMBER:		#####
SHEET:		A004
DRAWING NUMBER:	OF:	16 24
DRAWING NAME:		Roof Plan

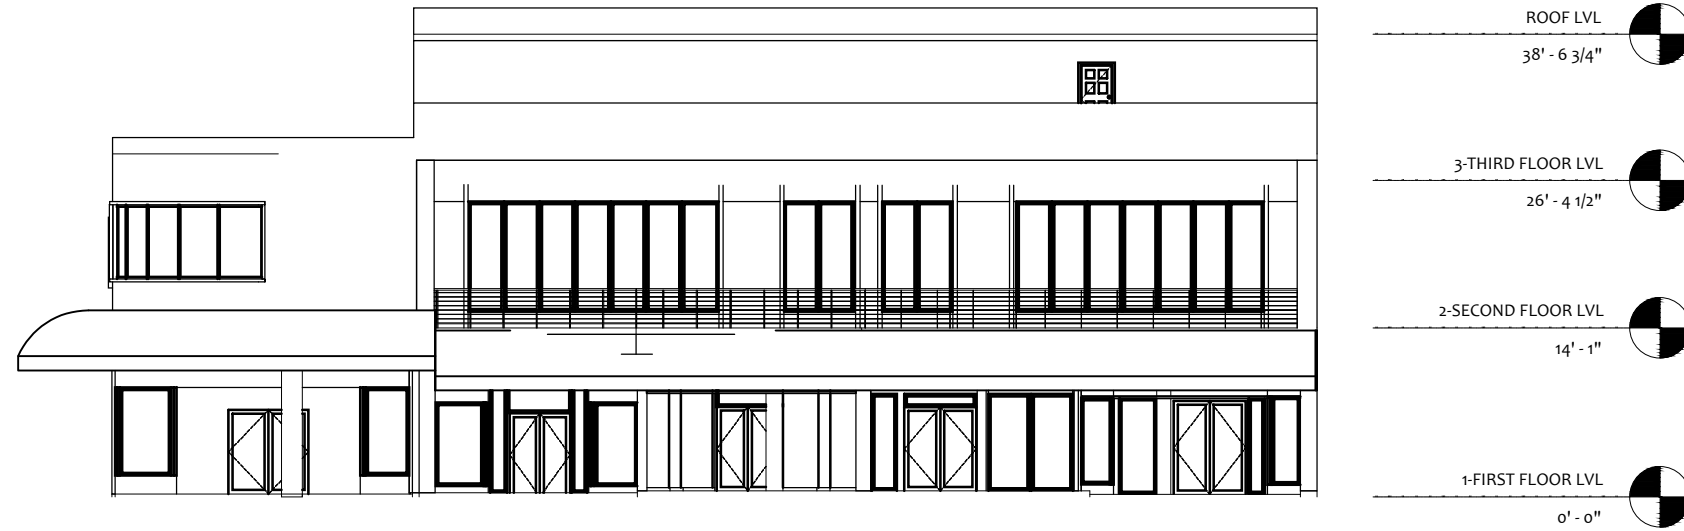


② SOUTH ELEVATION

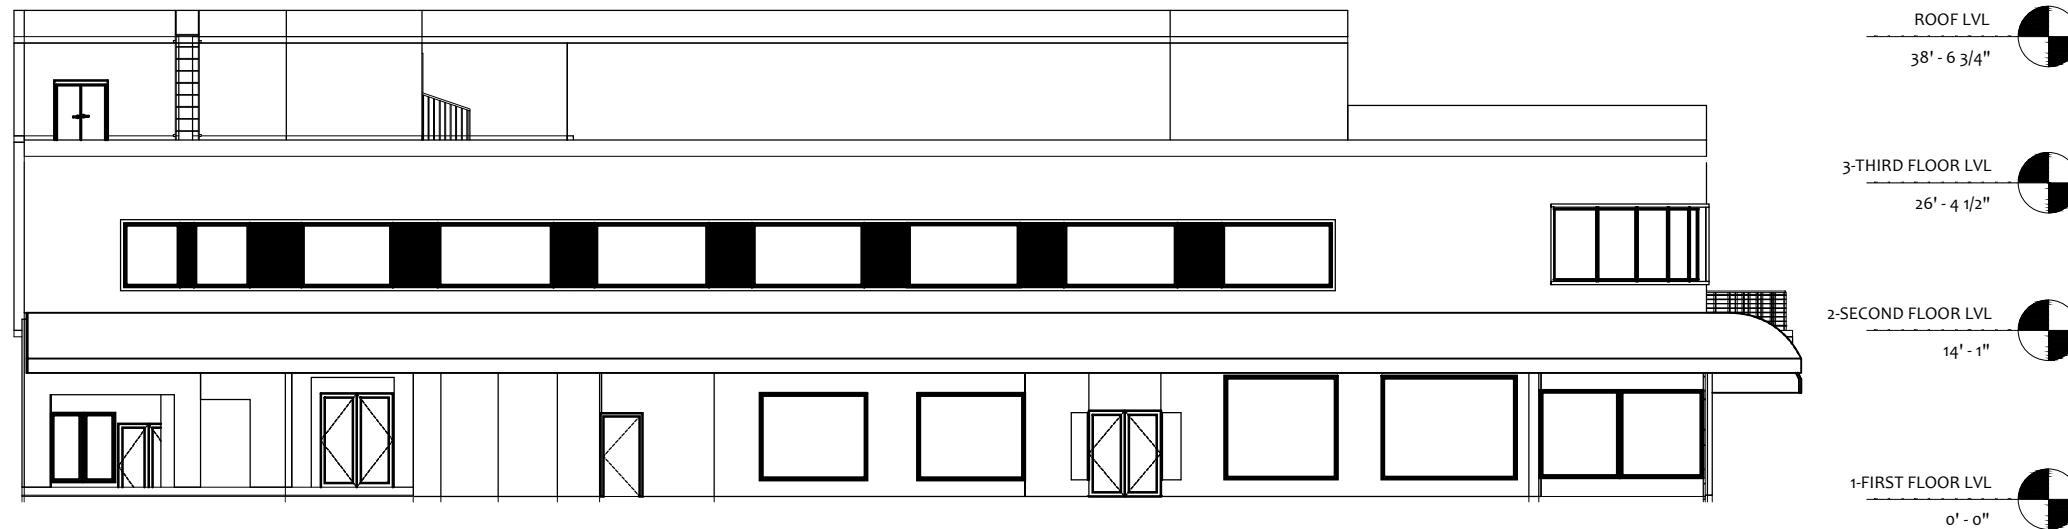

① WEST ELEVATION


FLOOR GROSS SF:

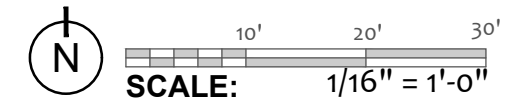

OWNER:

CLIENT:

- ELEC PANEL - RECESSED
- ELEC PANEL - SURFACE

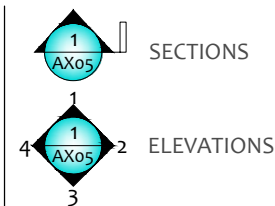


Arktech Solutions LLC.
10804 Inside Loop
Orlando, FL 32825
tel: (407) 205-7787
www.ArktechSolution.com


FC NAME:	---
FCID:	N/A
FC ADDRESS:	---

FIELD SURVEYOR:	---
PROJECT DIRECTOR:	---
CHECKED BY:	---
DATE COMPLETED:	05/03/2022


PROJECT NUMBER:	#####
SHEET:	AX05.1
DRAWING NUMBER:	17
OF:	24
DRAWING NAME:	Exterior Elevations

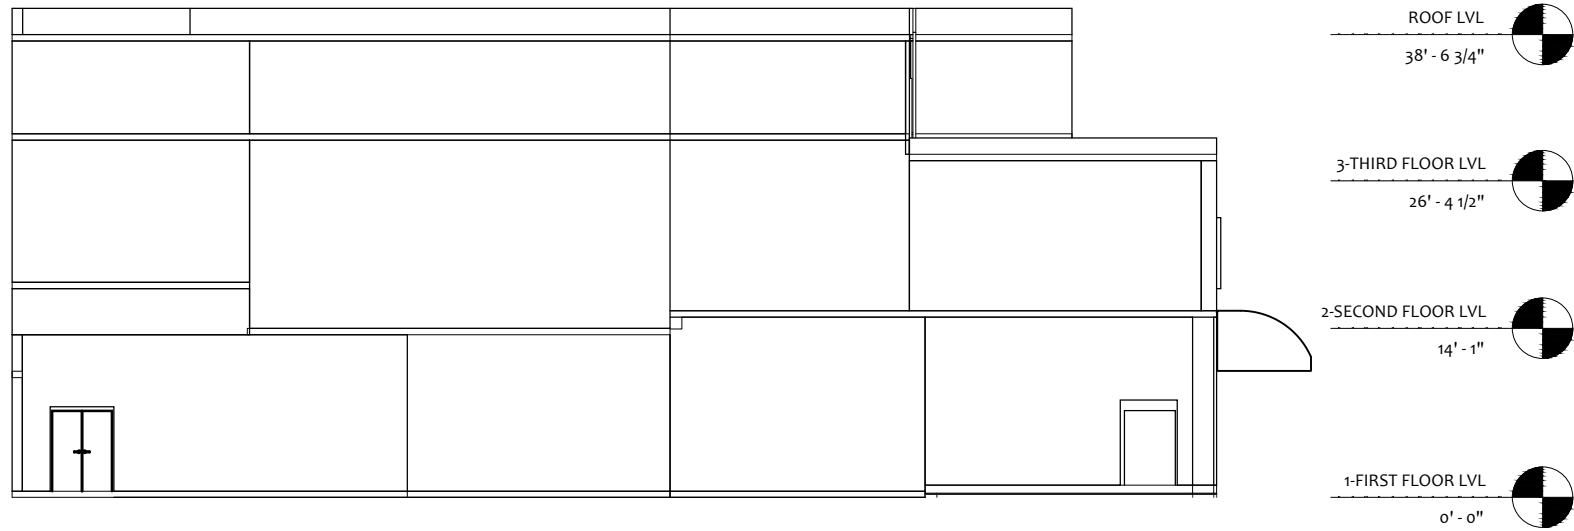

② NORTH ELEVATION


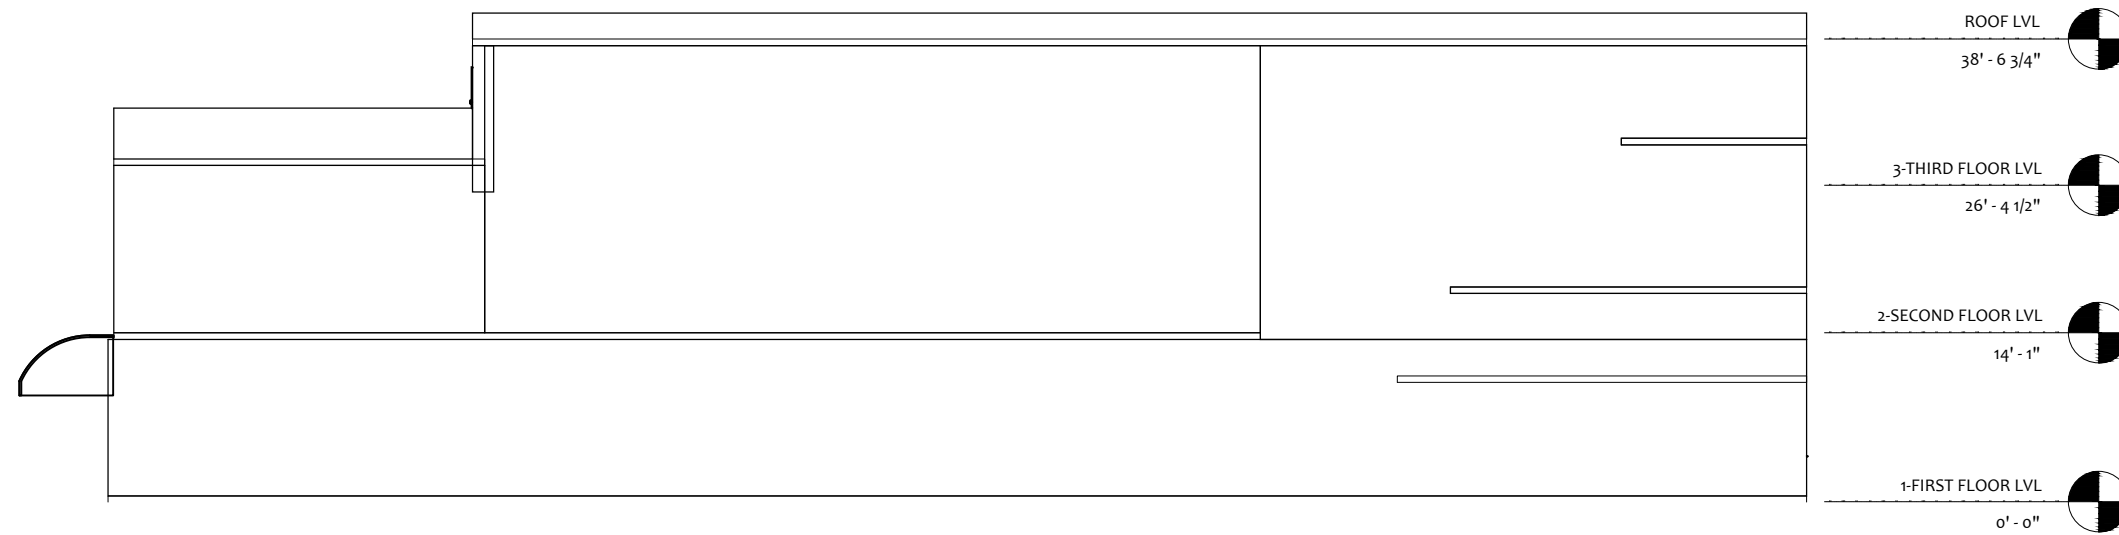


① EAST ELEVATION

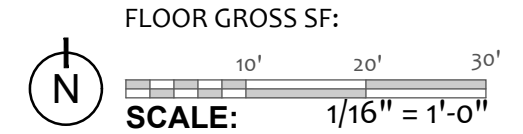

OWNER: CLIENT:


- ELEC PANEL - RECESSED
- ELEC PANEL - SURFACE

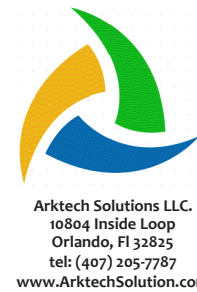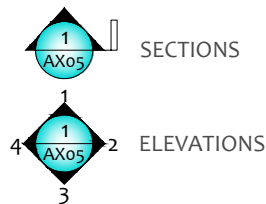


FC NAME:	---
FCID:	N/A
FC ADDRESS:	---

FIELD SURVEYOR:	---
PROJECT DIRECTOR:	---
CHECKED BY:	---
DATE COMPLETED:	05/03/2022

PROJECT NUMBER:	####
SHEET:	AX05.2
DRAWING NUMBER:	18
OF:	24
DRAWING NAME:	Exterior Elevations

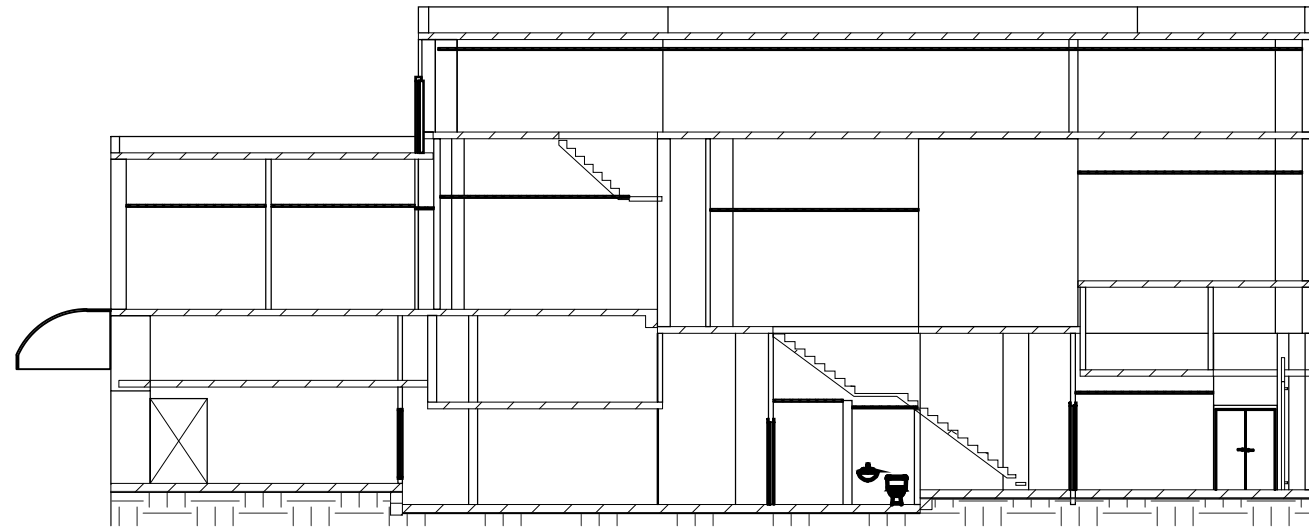


② SECTION A

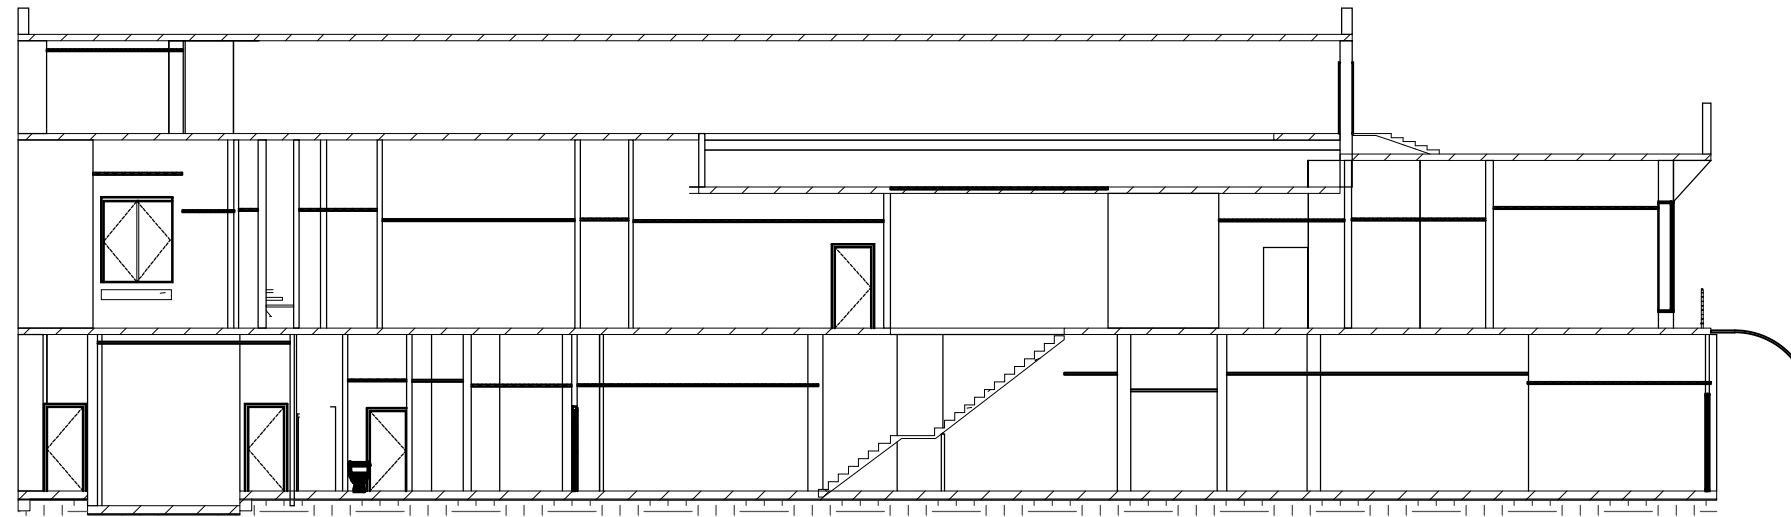

② SECTION B


FLOOR GROSS SF:

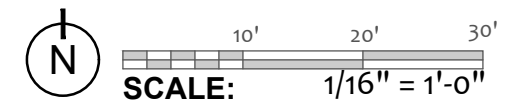

OWNER:

CLIENT:

- ELEC PANEL - RECESSED
- ELEC PANEL - SURFACE

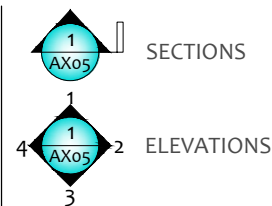


Arktech Solutions LLC.
10804 Inside Loop
Orlando, FL 32825
tel: (407) 205-7787
www.ArktechSolution.com


FC NAME:	---
FCID:	N/A
FC ADDRESS:	---

FIELD SURVEYOR:	---
PROJECT DIRECTOR:	---
CHECKED BY:	---
DATE COMPLETED:	05/03/2022

PROJECT NUMBER: ####	
SHEET: AX06.1	
DRAWING NUMBER: 19	OF: 24
DRAWING NAME: Sections	

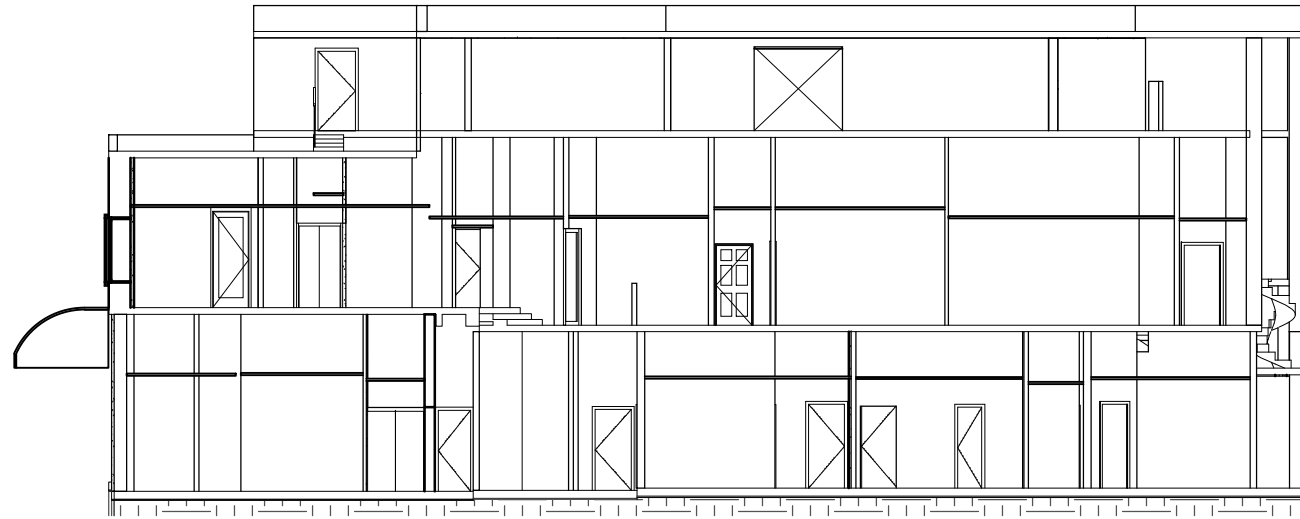


② SECTION C

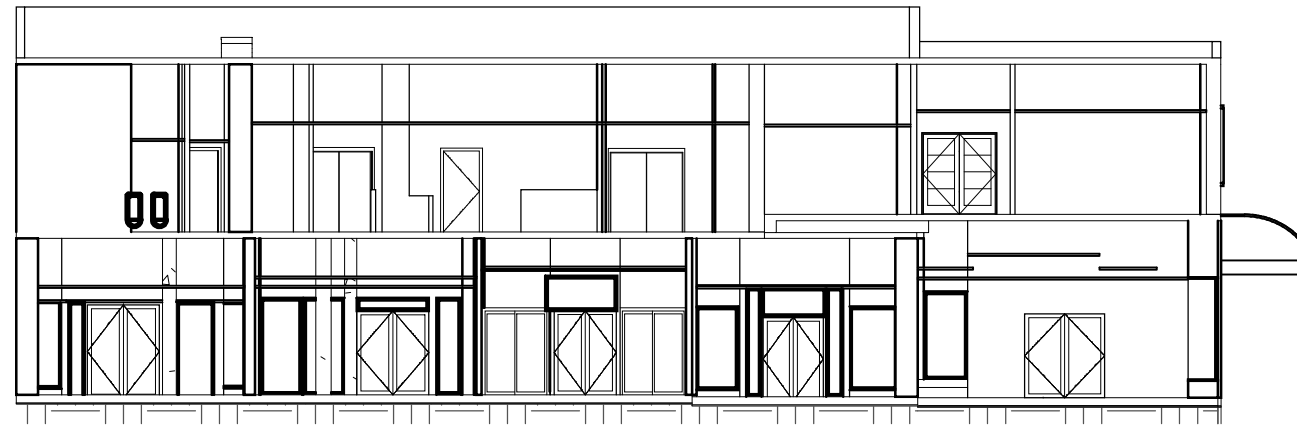

② SECTION D


FLOOR GROSS SF:

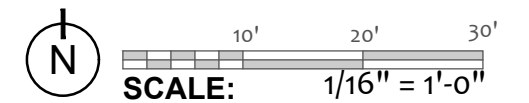

OWNER:

CLIENT:

- ELEC PANEL - RECESSED
- ELEC PANEL - SURFACE

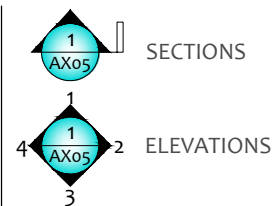


Arktech Solutions LLC.
10804 Inside Loop
Orlando, FL 32825
tel: (407) 205-7787
www.ArktechSolution.com


FC NAME:	---
FCID:	N/A
FC ADDRESS:	---

FIELD SURVEYOR:	---
PROJECT DIRECTOR:	---
CHECKED BY:	---
DATE COMPLETED:	05/03/2022

PROJECT NUMBER:	####
SHEET:	AX06.2
DRAWING NUMBER:	20
OF:	24
DRAWING NAME:	Sections

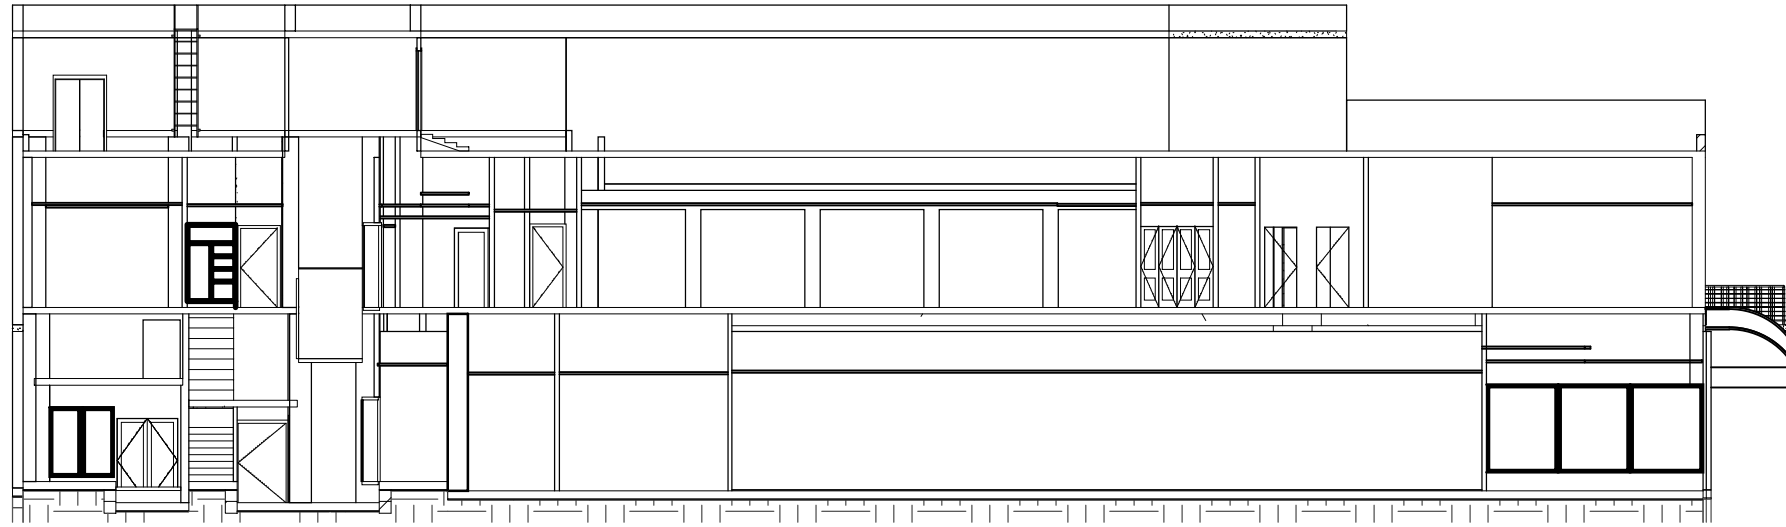


② SECTION E

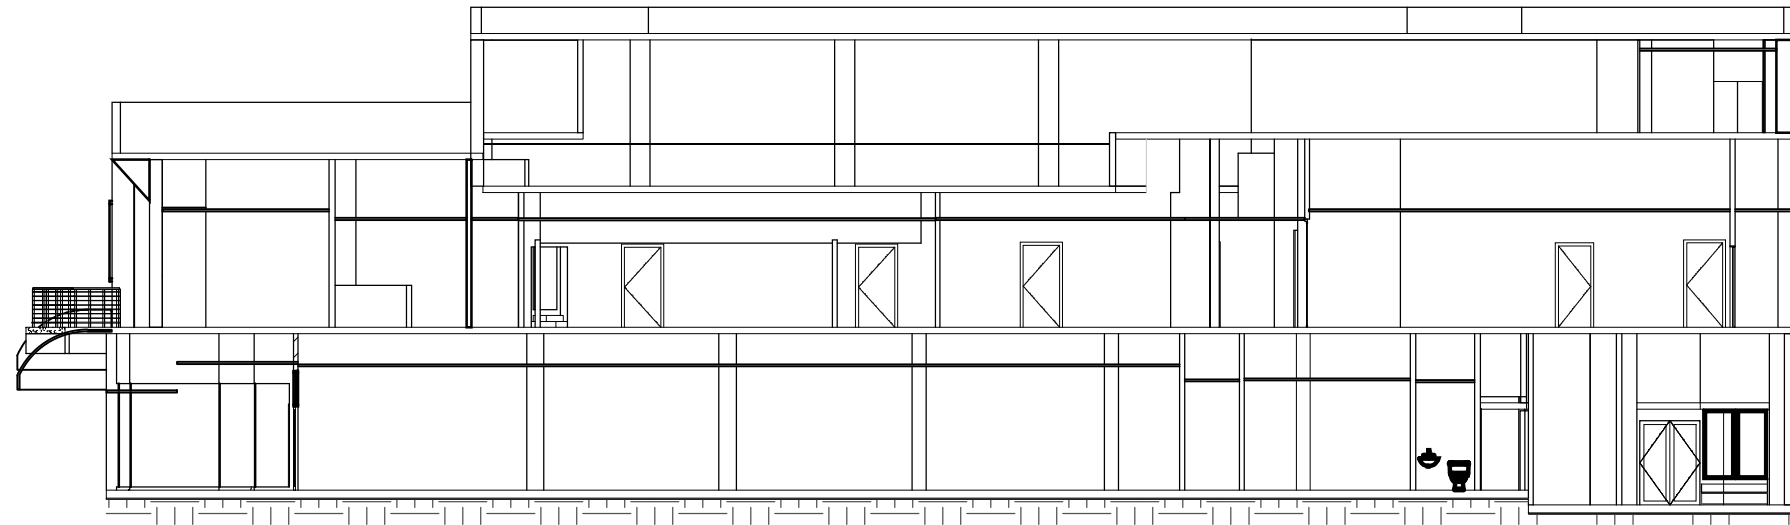



② SECTION F

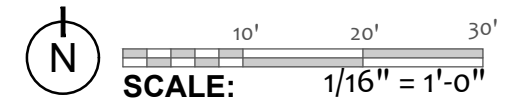
FLOOR GROSS SF:



OWNER:

CLIENT:

-  ELEC PANEL - RECESSED
-  ELEC PANEL - SURFACE

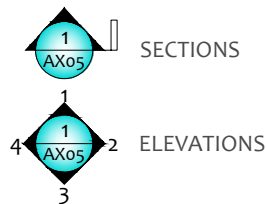


Arktech Solutions LLC.
10804 Inside Loop
Orlando, FL 32825
tel: (407) 205-7787
www.ArktechSolution.com


FC NAME:	---
FCID:	N/A
FC ADDRESS:	---

FIELD SURVEYOR:	---
PROJECT DIRECTOR:	---
CHECKED BY:	---
DATE COMPLETED:	05/03/2022


PROJECT NUMBER:	####
SHEET:	AX06.3
DRAWING NUMBER:	21
OF:	24
DRAWING NAME:	Sections

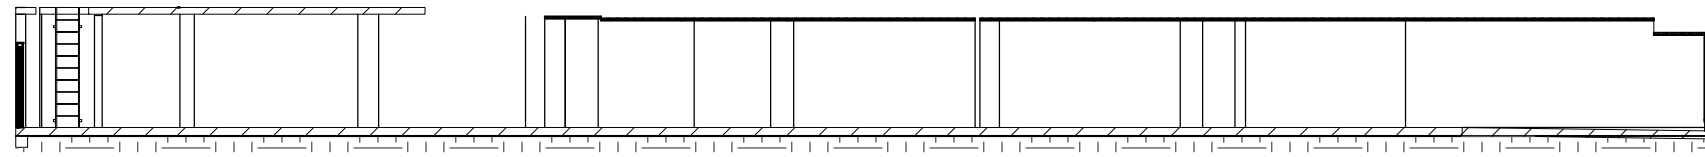


1 INTERIOR ELEVATION AX01

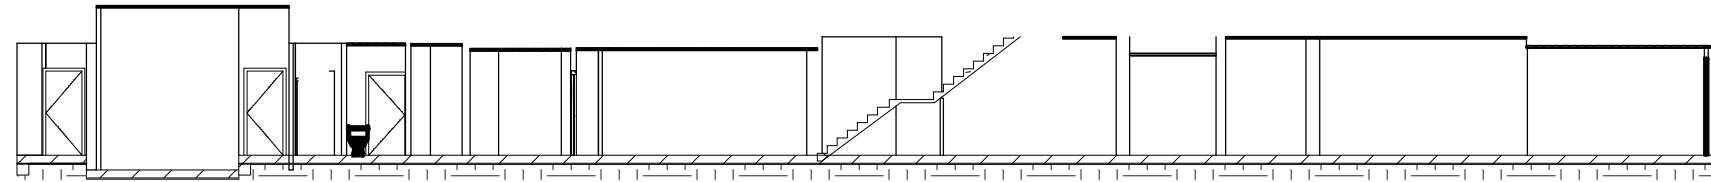

2 INTERIOR ELEVATION AX02

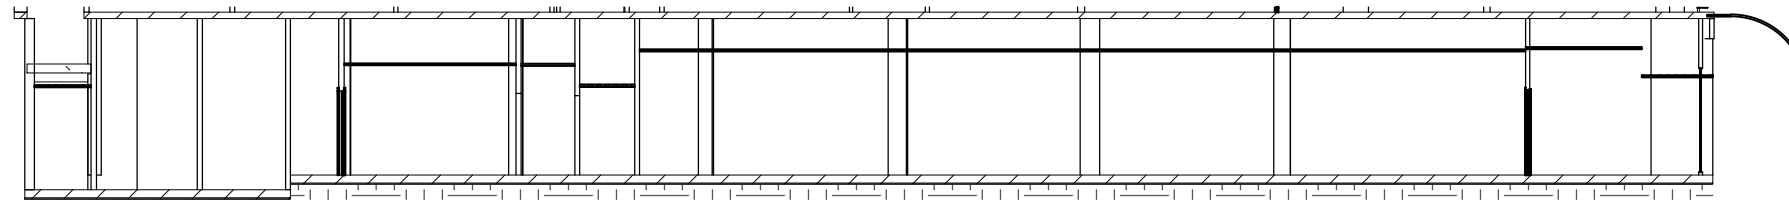


3 INTERIOR ELEVATION AX03

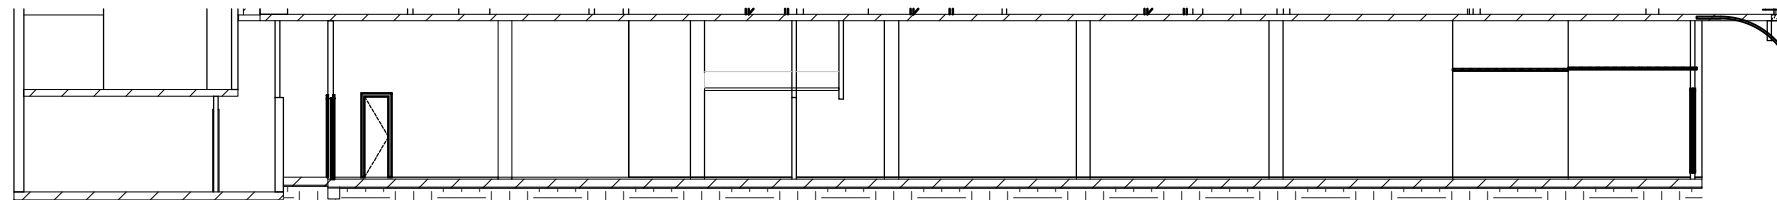

4 INTERIOR ELEVATION AX04


FLOOR GROSS SF:

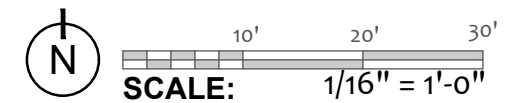

OWNER:

CLIENT:


- ELEC PANEL - RECESSED
- ELEC PANEL - SURFACE

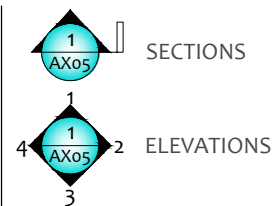


FC NAME:	---
FCID:	N/A
FC ADDRESS:	---

FIELD SURVEYOR:	---
PROJECT DIRECTOR:	---
CHECKED BY:	---
DATE COMPLETED:	05/03/2022


PROJECT NUMBER:	####		
SHEET:	AX07.1		
DRAWING NUMBER:	22	OF:	24
DRAWING NAME:		Interior Elevations	

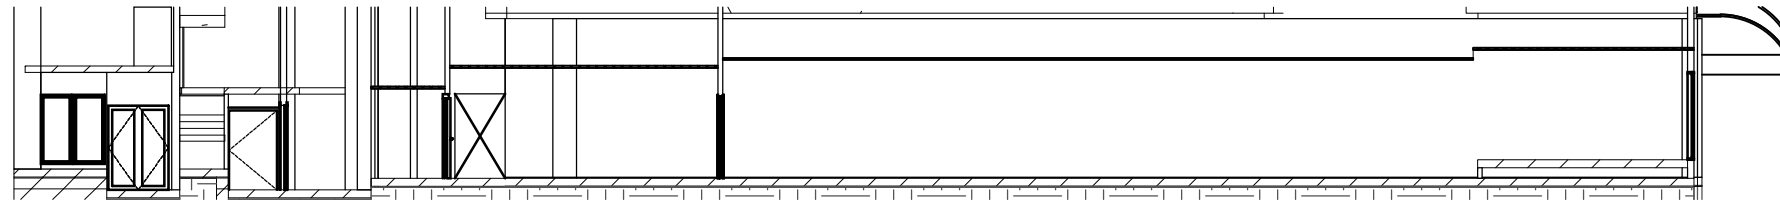


5 INTERIOR ELEVATION AX05

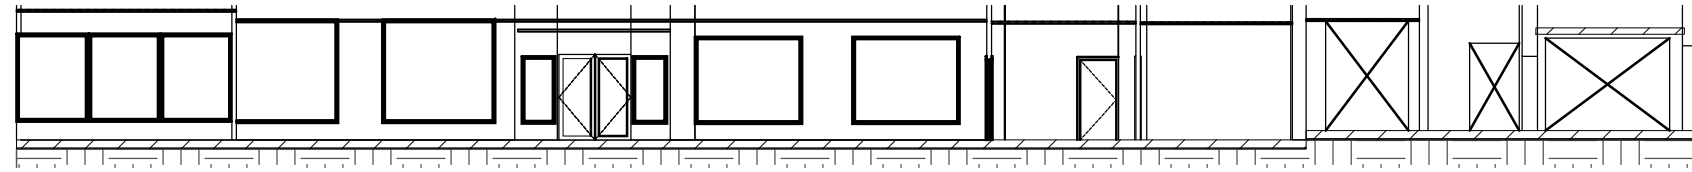


6 INTERIOR ELEVATION AX06

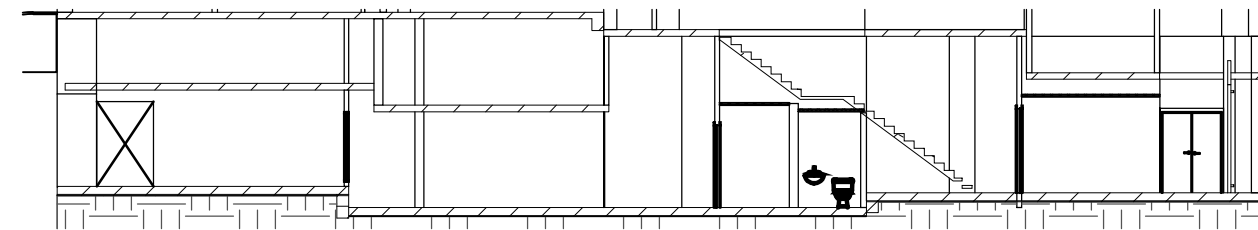


7 INTERIOR ELEVATION AX07

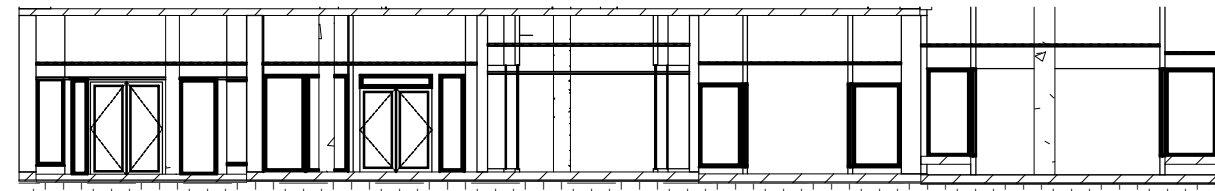

8 INTERIOR ELEVATION AX08

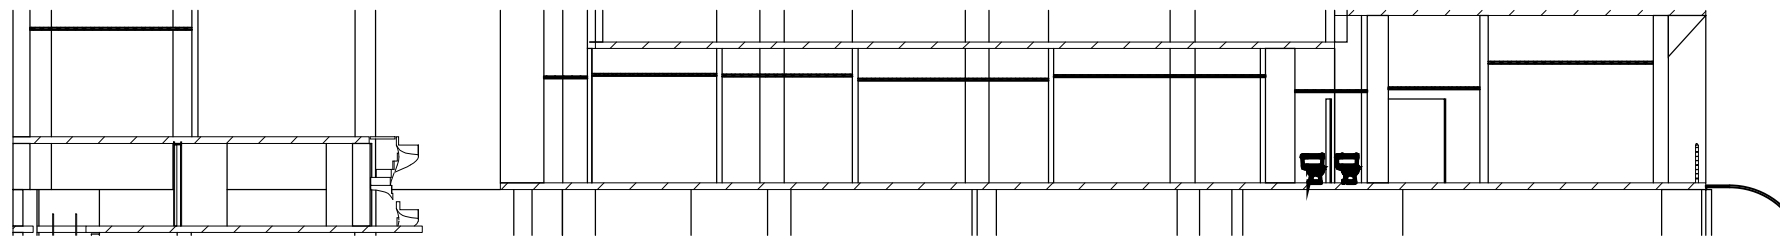


9 INTERIOR ELEVATION AX09

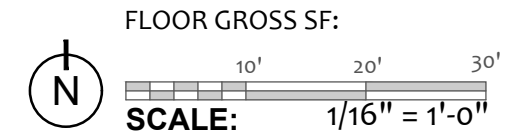

OWNER: CLIENT:


- ELEC PANEL - RECESSED
- ELEC PANEL - SURFACE

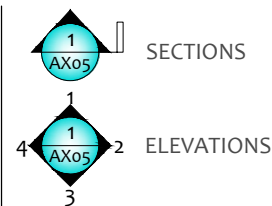


FC NAME:	---
FCID:	N/A
FC ADDRESS:	---

FIELD SURVEYOR:	---
PROJECT DIRECTOR:	---
CHECKED BY:	---
DATE COMPLETED:	05/03/2022


PROJECT NUMBER:	####
SHEET:	AX07.2
DRAWING NUMBER:	23
OF:	24
DRAWING NAME:	Interior Elevations

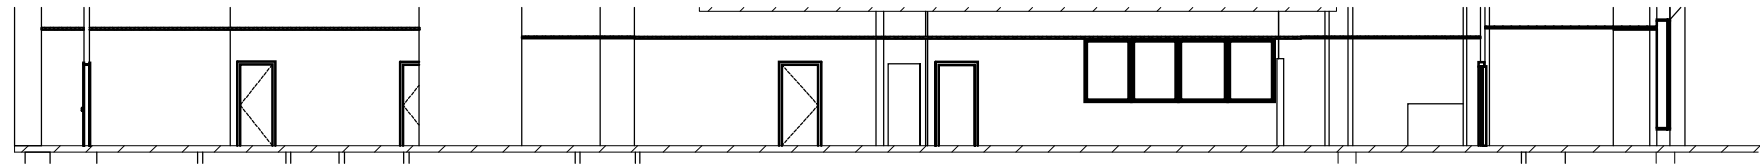


10 INTERIOR ELEVATION AX10

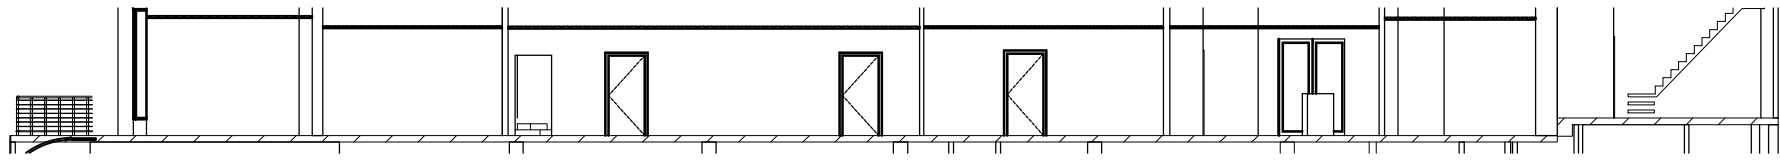


11 INTERIOR ELEVATION AX11

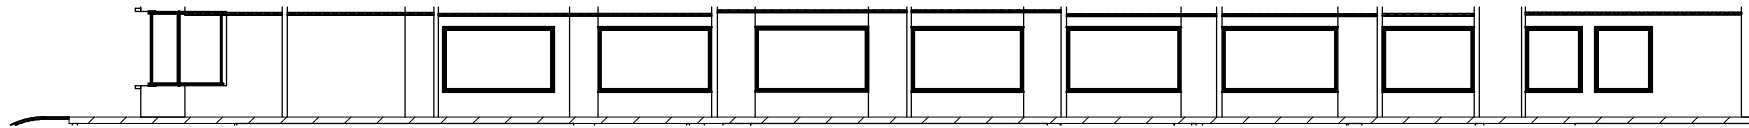

12 INTERIOR ELEVATION AX12

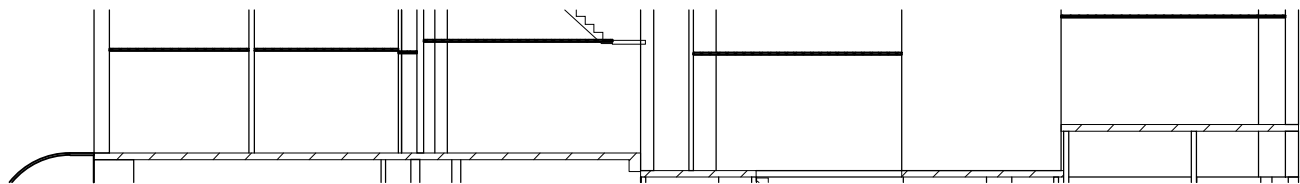


13 INTERIOR ELEVATION AX13

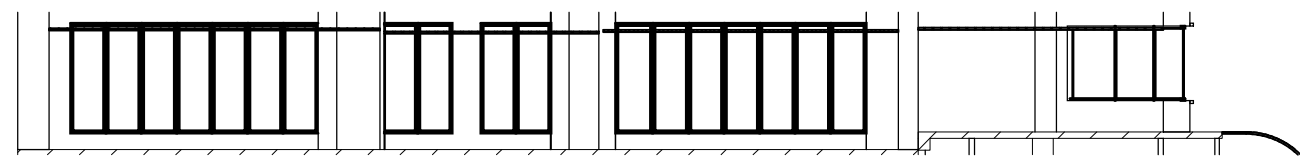

14 INTERIOR ELEVATION AX14



FLOOR GROSS SF:

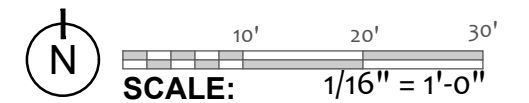

OWNER:

CLIENT:

- ELEC PANEL - RECESSED
- ELEC PANEL - SURFACE

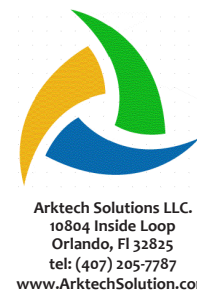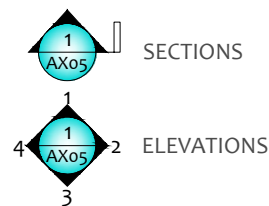

FC NAME:	---
FCID:	N/A
FC ADDRESS:	---

FIELD SURVEYOR:	---
PROJECT DIRECTOR:	---
CHECKED BY:	---
DATE COMPLETED:	05/03/2022

PROJECT NUMBER:	####
SHEET:	AX07.3
DRAWING NUMBER:	24
OF:	24
DRAWING NAME:	Interior Elevations